

Section 22 Township 12 Range 17WWell No. #1 SchmidtCompany Bill Graham

|  |  |  |  |  |  |  |   |
|--|--|--|--|--|--|--|---|
|  |  |  |  |  |  |  |   |
|  |  |  |  |  |  |  |   |
|  |  |  |  |  |  |  |   |
|  |  |  |  |  |  |  |   |
|  |  |  |  |  |  |  | 0 |
|  |  |  |  |  |  |  |   |
|  |  |  |  |  |  |  |   |
|  |  |  |  |  |  |  |   |

NORTH

WEST

EAST

SOUTH

KANSAS

Ellis

Sec. 22 Twp. 12 R. 17W

Well No. #1 Schmidt Farm

Bill Graham Company

Wildcat


330' Ft. from N. Line

Ft. from S. Line

330' Ft. from E. Line

Ft. from W. Line

NE SE

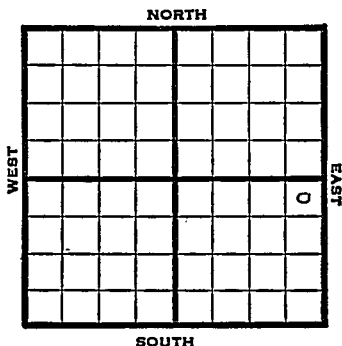

1948

Elev. 2107' REPORT

5/12

8" @ 213'

Anhy. 1285'

Drlg. 2000'

5/19

Lansing 3359'

Drlg. 3461'

5/26

Re Arb 3692'


TD 3710'

**ABANDONED.**

Map No. \_\_\_\_\_ Sec. 22 Twp. 12 R. 17WWell No. 1 Schmidt\_\_\_\_\_Bill Graham\_\_\_\_\_Company\_\_\_\_\_FIRST REPORT\_\_\_\_\_Contractor

NE SE

## SECTION PLAT

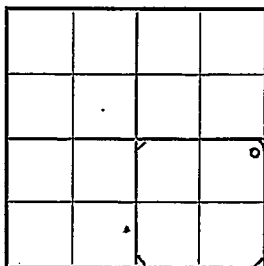330 Ft. from N. Line\_\_\_\_\_Ft. from S. Line330 Ft. from E. Line\_\_\_\_\_Ft. from W. LineEllis County

Location: \_\_\_\_\_

Rig up \_\_\_\_\_

Drilling and Remarks: \_\_\_\_\_

8" @ 213

anhy 1285

drlg. 2000

## RECORD

Cased \_\_\_\_\_ in., \_\_\_\_\_ ft.

Sand \_\_\_\_\_

Gas \_\_\_\_\_

Oil \_\_\_\_\_

Total Depth \_\_\_\_\_

## PRODUCTION

1st 24-hrs. Nat. \_\_\_\_\_

1st 24 hrs. after shot \_\_\_\_\_

Gas \_\_\_\_\_ Cu. Ft.

Dry Hole \_\_\_\_\_

Abandoned \_\_\_\_\_

Date

MAY 12 194819S. J. LEWISScout

Map No. 71 Sec. 22 Twp. 12 R. 17W

Well No. 1 Schmidt

Bill Graham

Company

**ABANDONED**

Contractor

NE SE


*E12102*  
SECTION PLAT

330 Ft. from N. Line

\_\_\_\_\_ Ft. from S. Line

330 Ft. from E. Line

\_\_\_\_\_ Ft. from W. Line

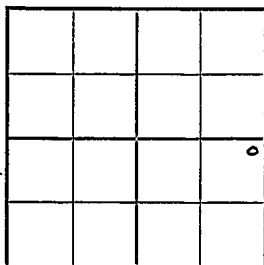

Ellis County

Location \_\_\_\_\_

Rig up \_\_\_\_\_

Drilling and Remarks:

*Re Cor 3692*

RECORD

Cased \_\_\_\_\_ in., \_\_\_\_\_ ft.

Sand \_\_\_\_\_

Gas \_\_\_\_\_

Oil \_\_\_\_\_

Total Depth 3274

PRODUCTION

1st 24 hrs. Nat. \_\_\_\_\_

1st 24 hrs. after shot \_\_\_\_\_

Gas \_\_\_\_\_ Cu. Ft.

Dry Hole \_\_\_\_\_

Abandoned \_\_\_\_\_

Date

MAY 26 1948

19

S. J. LEWIS

Scout