


Section 22 Township 12 Range 17W

Well No. 1 Schneider

Company Huber & Padco

Schneider Pool

NORTH

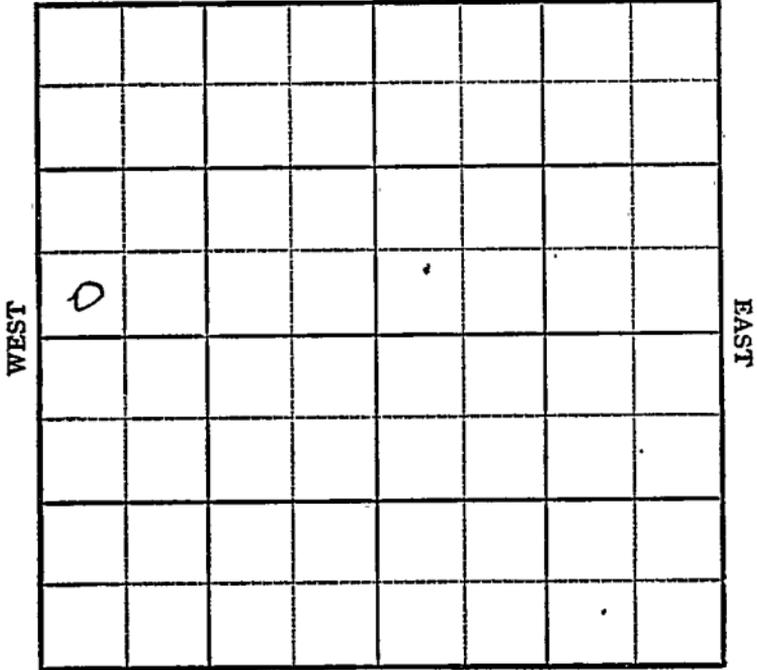

SOUTH

Sec. 22 Twp. 12 R. 17W

Well No. 1 Schneider Farm

Huber & Padco Company

Schneider Pool


\_\_\_\_\_ Ft. from N. Line

330 Ft. from S. Line

\_\_\_\_\_ Ft. from E. Line

330 Ft. from W. Line

SW NW

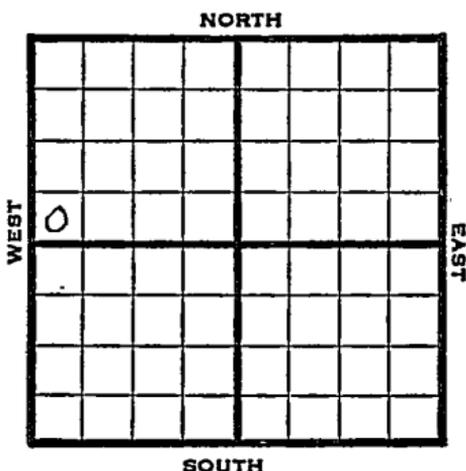

1948

Elev. 2120' REPORT

- 9/1 Location
- 9/8 8" @ 231' ;  
Drlg 1620'
- 9/14 Drlg 2750'
- 9/22 Lans 3375'  
Cong. 3643'  
Arb. 3801'  
TD 3819'

~~ABANDONED~~

Ellis County Kansas State

Map No. \_\_\_\_\_ Sec. 22 Twp. 12 R. 17W

Well No. 1 Schneidler

Huber & Padco Company

**FIRST REPORT** Contractor

SW NW

SECTION PLAT


\_\_\_\_\_ Ft. from N. Line

330 Ft. from S. Line

\_\_\_\_\_ Ft. from E. Line

330 Ft. from W. Line

Schneidler Pool

Remarks:

Location

Date SEP 1 1948

Scout S. J. LEWIS

Ellis County Kansas State

Map No. 71 Sec. 22 Twp. 12 R. 17W

Well No. 1 Schneider

Huber & Padco Company

**ABANDONED**

Contractor

*E. I. 2/20*

SECTION PLAT

SW NW


         Ft. from N. Line

330 Ft. from S. Line

         Ft. from E. Line

330 Ft. from W. Line

Schneider Pool

Remarks:

*Lease 3375*

*Lease 3643*

*Lease 3801*

*Lease 3879*

*Handwritten notes and scribbles*

Date  
SEP 22 1948

Scout  
S. J. LEWIS