

KANSAS

Ellis


Form 51-5M-7-39-Palace

Section 22 Township 12 Range 18-W

Well No. #1 Jensen

Company Skelly

NORTH **Walters Pool**

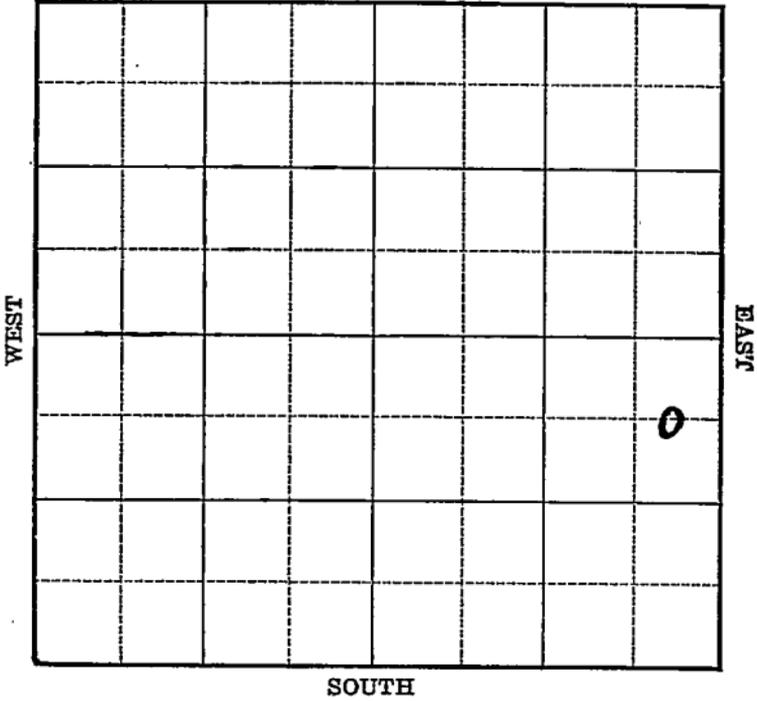

1940
5/22

Arb. 3682'

5" - 3682'

T.D. 3718'

7750 acid.

Potential 492 bbls., pump.

COMPLETED

Map No. 71 Sec. 22 Twp. 12 R. 18WWell No. 1 JensenSkelly

Company

Contractor

FIRST REPORT**C E L N E S E****SECTION PLAT**

660 Ft. from N. Line Ft. from S. Line330 Ft. from E. Line Ft. from W. Line**WALTERS POOL**Location Rig up Drilling and Remarks:
Rotary**RECORD**Cased in., ft.Sand Gas Oil Total Depth **PRODUCTION**1st 24 hrs. Nat. 1st 24 hrs. after shot Gas Cu. Ft.Dry Hole Abandoned

Date

MAR 20 1940 19S. J. LEWIS Scout

Map No. 71 Sec. 22 Twp. 12 R. 18W

Well No. 1 Jensen

Skelly Company

Contractor

COMPLETED

SECTION PLAT

C E L N E S E

660 Ft. from N. Line

_____ Ft. from S. Line

330 Ft. from E. Line

_____ Ft. from W. Line

			2

WALTERS POOL

Location _____

Rig up _____

Drilling and Remarks:

Cor 3682.

5" @ 3682

7750 acid

Pump 492 P.S.

RECORD

Cased _____ in., _____ ft.

Sand _____

Gas _____

Oil _____

Total Depth 3718

PRODUCTION

1st 24 hrs. Nat. _____

1st 24 hrs. after shot _____

Gas _____ Cu. Ft.

Dry Hole _____

Abandoned _____

Date

MAY 22 1940

S. J. LEWIS Scout