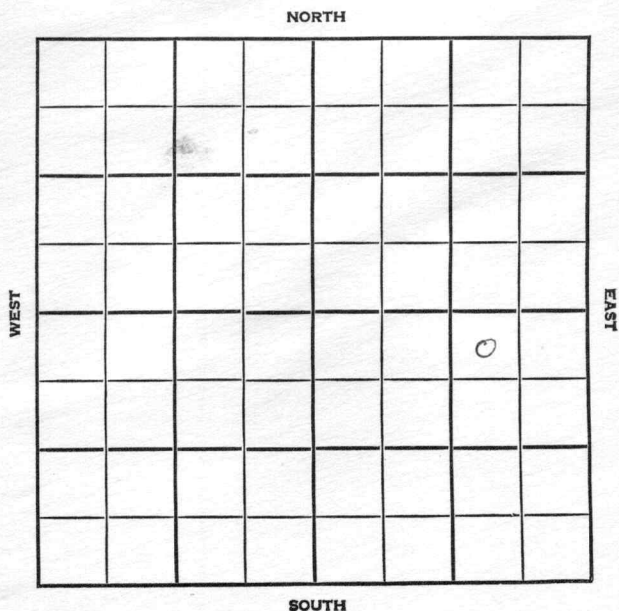


Section 22 Township 12 Range 18WWell No. #4 JensenCompany Petroleum Inc.


Ellis			KANSAS		
SEC.	TWP.	R.			
22	12	18W			

WELL NO. #4 Jensen FARM

COMPANY Petroleum Inc.

CONTRACTOR Garvey T.

Koblitz
_____ FT. FROM N. LINE
_____ FT. FROM S. LINE
_____ FT. FROM E. LINE
_____ FT. FROM W. LINE

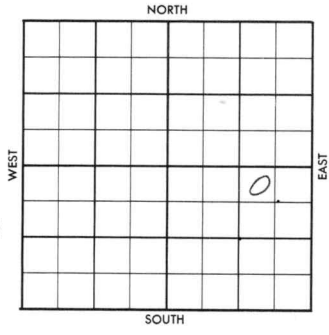

NW NE SE

1956	ELEVATION	REPORT
------	-----------	--------

8-29 Comm. 8-26-56
8" @ 206 w/135
Drlg. 1615'

ABANDONED

County Ellis

Elev. _____

Sec. 22Twp. 12Rge. 18WCompany Petroleum Inc.FarmName JensenNo. 4

TOPS

DEPTH

LOG

DATUM

Loc. in Sec. _____

Anh. _____

NWNE SE

Tp. _____

H. _____

Tr. _____

Dg. _____

Bl. _____

L. _____

K.C. _____

Geol. _____

B.K.C. _____

Ce. _____

Contr. _____

C. _____

Garvey T.

M. _____

M. _____

K. _____

Pool

Mz. _____

Koblitz

Mq. _____

V. _____

S. _____

S. _____

A. _____

R. _____

Pe. _____

G. _____

T.D. _____

FIRST REPORT

AUG 29 56

Date Comm. 8/26/568" @ 206 w/ 135 Drlg. 1615

SEP 2 1956

County EllisElev. 2162Sec. 22Twp. 12Rgs. 18WCompany Petroleum Inc.Farm Name JensenNo. 1

TOPS	DEPTH	LOG	DATUM	Loc. in Sec.
Anh.				
Tr.	3142			FACE SW
H.	3373			
Tr.	3394			
Dg.				
Bl.				
L.	3420			
M.C.				Geol.
B.K.C.				Contr.
Ce.				Garvey T #8
C.				
M.				
M.				Pool
K.				Loblitz
Mz.				
Me.				
V.				
S.	3668			
S.				
A.	3679			
R.				
Pe.				
G.				
T.D.	3710			

ABANDONED

SEP 12 '56

Date Comm. 8/26/56

8" @ 206 w/ 135 Drlr. 1615

SEP 5 '56

DST 3371-3460 30" rec. 140'

Md 500/15" DST 3459-85 w/

30" rec. 20' Md 350/15" DST

3482-3525 45" rec. 345' Md

BHP 900/20" DST 3680-83 SEP 12 '56

sp 1hr rec. 15' Md BHP 25

DST 3683-88 1hr rec. 20' Md

BHP 0 DST 3688-98 1hr rec.

15' Md BHP 360 DST 3698
-3760 1hr rec 2045' SW
BHP 1000

D & A