


Ellis

KANSAS

Section 22 Township 12 Range 18W

Well No. #1 Jensen "C"

Company Trans-Era

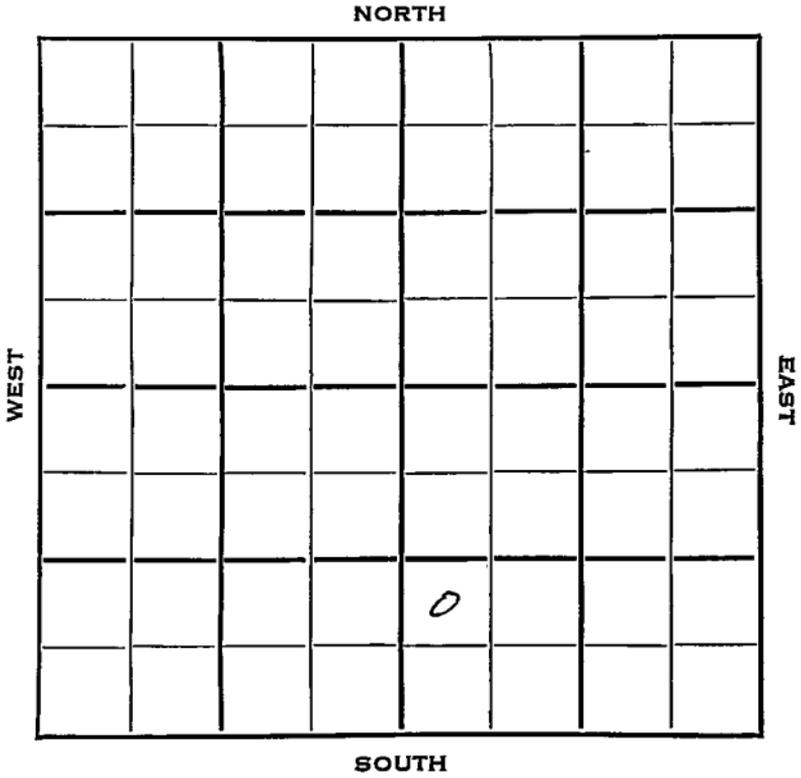

Sec. 22 Twp. 12 R. 18W

Well No. #1 Jensen "C" Farm

Trans-Era Company

Trans-Era Contractor


Ft. from N. Line

990 Ft. from S. Line

Ft. from E. Line

330 Ft. from W. Line

NW SW SE

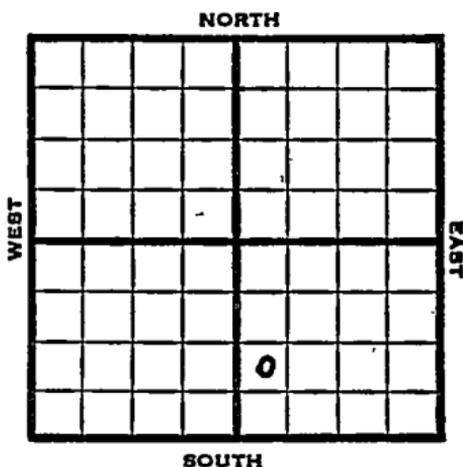

1953 Elev. 2163' REPORT

3/25 Spud 3-22-53
8" @ 189
Drlg. 460'

4/2 Anhy 1415 Heeb 3374 Lans 3419
Drlg. 3494'

4/9 Arb 3683
RTD 3686
5" @ 3683

4/16 Testing

4/23 NR

4/30 "

5/7 "

5/20 Spud 3-22-53 Oil well TD 3690
8" @ 189 Anhy 1415 Heeb 3374
Lans 3419 Arb. 3683 TD 3686
5" @ 3683

DST 3436-3511 open 1 hr rec 660' GCM
300' G & OCM 1000#

DST 3515-25 open 1 hr. rec 480' VSOCM
& wtr. Simp. 3681' CO to 3686

20 GOPH 250 A DD 3687 24 GOPH
3% wtr. 3 hr. DD 3688 500 A

S/1½ BOPH DD 3680 1000 A S/2½ BOPH
4% wtr. 2500 A S/20 BOPH 4% wtr.
Comp. 50 BOPD 4% wtr.

COMPLETED

