


Section 22 Township 12 Range 18 W

Well No. # 2 Jansen "C"

Company Trans Era Pet.

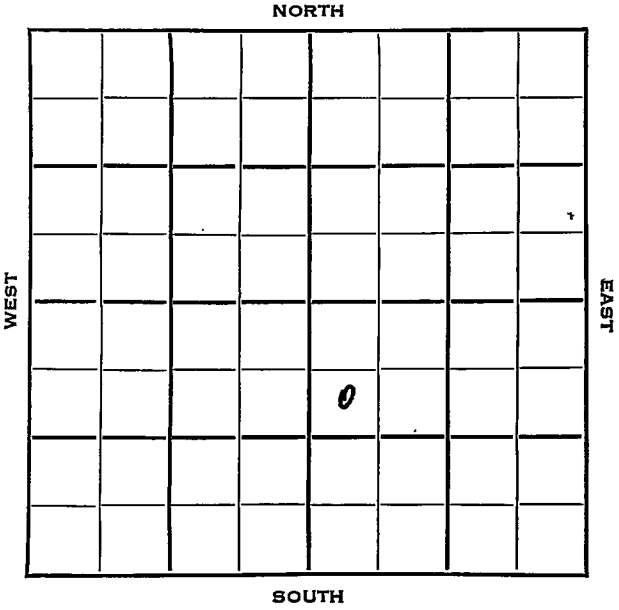


SEC.	TWP.	R.
22	12	18W

WELL NO. **2 Jansen "C"** FARM

COMPANY **Trans Era Petr.**

CONTRACTOR **Trans-Era Koblitz Pool**

990 Ft. from N. Line
 _____ Ft. from S. Line
 _____ Ft. from E. Line
330 Ft. from W. Line

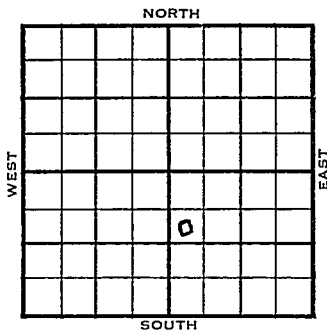

SW NW SE

	ELEVATION	REPORT
1953	2163'	

9/9 Spud 9-3-53
 8" @ 189'
 Anhy 1420'
 Drlg. 2475'

9/18 Heeb 3388' Lans 3434'
 Drlg. 3618'

9/23 Spud 9-3-53
 D&A
 TD 3721'
 8" @ 189'
 Anhy 1420', Heeb 3388', Lans 3434',
 Cong 3690', imp 3705', Arb 3710'
 DST 3712-21, opn 1 hr., rec. 78'
 mud & wtr. 750#
 TD 3721'
 D&A

ABANDONED

