

KANSAS


Ellis

FORM 51 5M 1-42 PETROL

Section 22 Township 12 Range 18-W

Well No. #1 Koblitz

Company Skelly

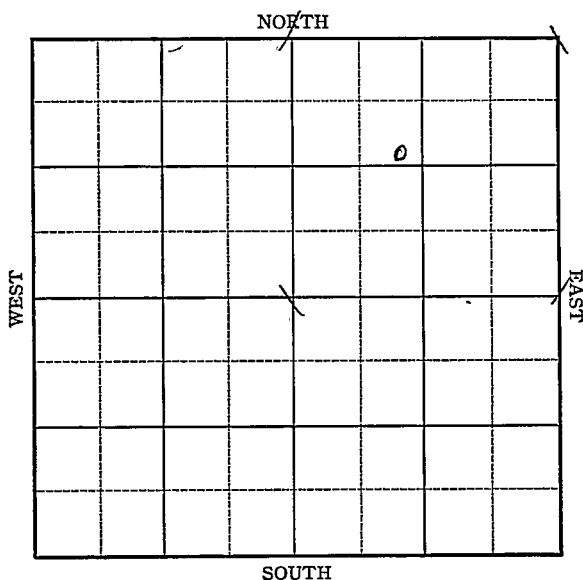

KANSAS

Ellis

Sec. 22 Twp. 12 R. 18-W

Well No. #1 Koblitz Farm

Skelly Company


1265 Ft. from N. Line

 Ft. from S. Line

 Ft. from E. Line

1190 Ft. from W. Line

Ells. 2160

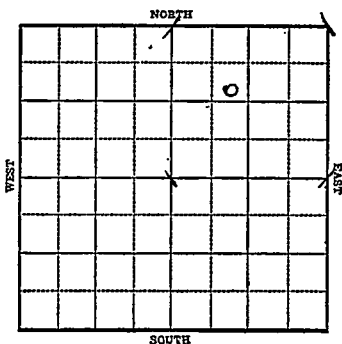

1943

R E P O R T

.5/19 Drlg. 125' S.W.D.
5/26 7" @ 522
T.D. 536' WOC.
6/2 580' fsg
6/9 Drlg. 871
6/16 Sand 515
5" Liner 633'
7" @ 533'
T.D. 879'
SWD

COMPLETED

KANSAS**Ellis**Map No. 77 Sec. 22 Twp. 12 R. 18WWell No. 1 KoblitzSkelly

Company


FIRST REPORT

Contractor

SE NW NE1265 Ft. from N. Line

Ft. from S. Line

Ft. from E. Line

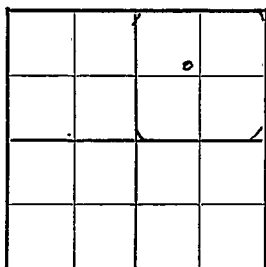1190 Ft. from W. Line**KOBLITZ POOL****SECTION PLAT**

Location _____

Rig up _____

Drilling and Remarks:

S.W.D.**Dr1g. 125'****RECORD**

Cased _____ in., _____ ft.

Sand _____

Gas _____

Oil _____

Total Depth _____

PRODUCTION

1st 24 hrs. Nat. _____

1st 24 hrs. after shot _____

Gas _____ Cu. Ft.

Dry Hole _____

Abandoned _____

Date

MAY 19 1943

19

S. J. LEWIS

Scout

KANSAS

Ellis

Map No. 71 Sec. 22 Twp. 12 R. 18WWell No. 1 KoblitzSkelly

Company

COMPLETED

Contractor

SE NW NE

SECTION PLAT

1265


Ft. from N. Line

Ft. from S. Line

Ft. from E. Line

1190

Ft. from W. Line

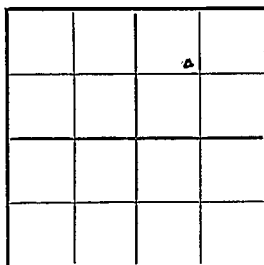

KOBLITZ POOL

Location

Rig up

Drilling and Remarks:

*Band 515**5" Line 633**7" 633**SW 1/4*

RECORD

Cased _____ in., _____ ft.

Sand _____

Gas _____

Oil _____

Total Depth 829

PRODUCTION

1st 24 hrs. Nat. _____

1st 24 hrs. after shot _____

Gas _____ Cu. Ft.

Dry Hole _____

Abandoned _____

Date

JUN 16 1943 19

S. J. LEWIS Scout