
FORM 51 25M 3-49 PETROL Ellis KANSAS

Section 22 Township 12 Range 18W

Well No. #4 Reeder

Company Petroleum Inc.

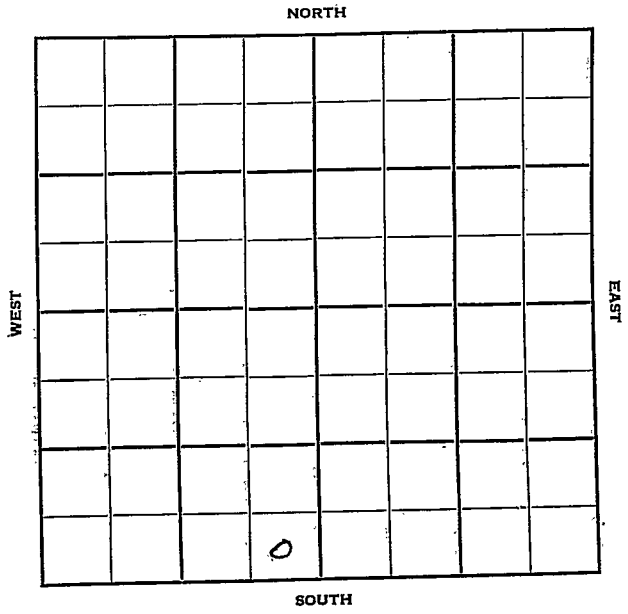

FORM 252-B
10M 8-51 TPCO.

Ellis KANSAS

Sec. 22 Twp. 12 R. 18W

Well No. #4 Reeder Farm

Petroleum, Inc. Company

Petroleum Inc. Contractor


Ft. from N. Line

330 Ft. from S. Line

330 Ft. from E. Line

Ft. from W. Line

SW¼ SE SE SW

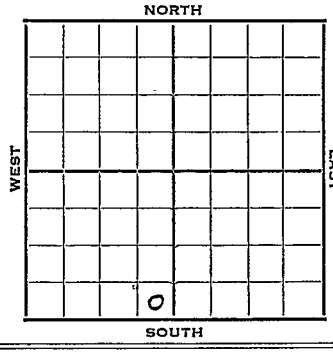

1952 Elev. 2154' REPORT

10/29 Spud 10-25-52
8" @ 200
Drlg. 1700'

11/5 Heeb. 3359 Tor. 3380
Lans. 3408
DST 3422-58, 1 hr. 150' muddy oil
360' oil 950#
Drlg. 3507'

11/12 DST 3474-3517, 1 hr. 510' muddy oil
1020' free oil 360' SW 1100 #
DST 3534-80, 1/4 hr 5'M
DST 3668-72, 10' HOCM 0#
Arb. 3367-72 RTD 5" @ 3670

11/20 CO 3672' S/10 gal OPH 300 A
S/6 BWPH plus 1 BOPH Sq. off

11/27 Sq shoe
CO 3672½ 1 boph 500A
150 bopd no wtr.

12/3 Spud 10-25-52
Oil Well
TD 3672½
8" @ 200
Heeb. 3359, Tor. 3380, Lans
3408

OVER

(Information Brought Forward)

1952
12/3 DST 3422-58, opn 1 hr., rec. 150' muddy oil, 360' oil 950#
DST 3474-3517, opn 1 hr., rec. 510' muddy oil, 1020' free oil, 360' sw, 1100#
DST 3534-80, opn ½ hr., rec. 5' mud, 0#
DST 3668-72, rec. 10' hocm 0#
Arb. 3667
TD 3672'
5" @ 3670 CO to 3672
S/10 goph 300A 5/6 bwph 1 bo
sq. shoe 3672 CO to 3672½
1 boph 500A 150 bopd
Comp. 150 bopd

COMPLETED

FORM 275 FOR SALE BY KANSAS BLUE PRINT CO.


County Ellis State Kansas

Sec. 22 (Blk. Twp.) 12 (Sur. Rge.) 18W Map No.

Operator Petroleum Inc.

Well No. 4 Farm Reeder

Elev. Location SE SE SW

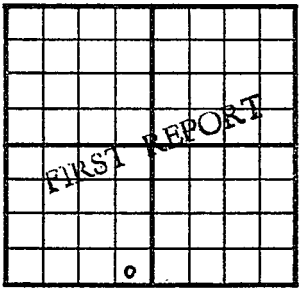

330 Ft. From S Line SW

330 Ft. From E Line Quarter

1st. Report OCT 29 1952

Completion

Remarks

Petroleum Inc. - Contr.

Spudding Date 10-25-52

Drlg. Data

8" @ 200 drlg. 1700

J. G. McGEHEE

FORM 275 FOR SALE BY KANSAS BLUE PRINT CO.


County Ellis State Kansas

Sec. 22 (Blk. Twp.) 12 (Sur. Rge.) 18W Map No.

Operator Petroleum Inc.

Well No. 4 Farm Reeder

Elev. 2154 Location SE SE SW

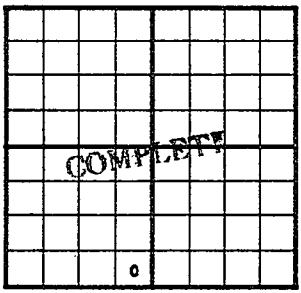

330 Ft. From S Line SW

330 Ft. From E Line Quarter

1st. Report

Completion DEC 3 1952

Remarks

Petroleum Inc. - Contr.

Spudding Date 10-25-52

Drlg. Data Oil well TD 3672½

8" @ 200 Heeb. 3359 Tor. 3380

Lans. 3408 DST 3422-58 open 1 hr.

Rec. 150' muddy oil 360' oil 950#

DST 3474-3517 open 1 hr. Rec. 510'

muddy oil 1020' free oil 360' sw

1100# DST 3534-80 open ½ hr. Rec. 5' mu

0# DST 3668-72 - Rec. 10' hocm 0#

Arb. 3667 TD 3672 5" @ 3670

CO to 3672 S/ 10 goph 300 A S/ 6 bwph

1 bo sq. shoe 3672 CO to 3672½

1 boph 500 A 150 bopd Comp. 150 bopd

J. G. McGEHEE