


Section 22 Township 12 Range 18W

Well No. #7 Reeder

Company Petroleum Inc.

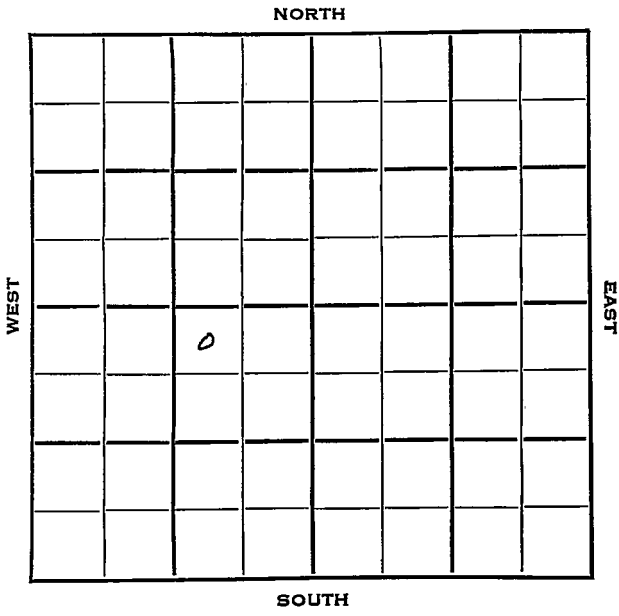


Sec. 22 Twp. 12 R. 18 WWell No. # 7 Reeder FarmPetroleum Inc. CompanyGarvey Contractor330 Ft. from N. Line

Ft. from S. Line

990 Ft. from E. Line

Ft. from W. Line

NW NE SW

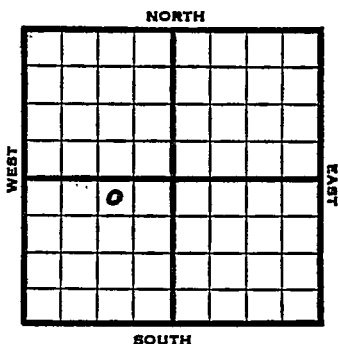

1953 Elev. 2149' REPORT

2/18 Spud 2-17-53
8" @ 195 WOC

2/26 Heeb 3363' Tor. 3386'
Drlg. 3540'

3/3 Spud 2-17-53
D&A
TD 3691
8" @ 915
Heeb 3363, Tor 3386, Lans 3408
DST 3482-3525, opn 1 hr., rec.
250' muddy gesw 1035#
TD 3691
D&A

ABANDONED

Elev.	Location	NW	NE	SW
-------	----------	----	----	----

FIRST REPORT

Spudding Date **2-17-53**

8th @ 195 WOC

County Ellis State Kansas

Sec. 22 (Blk. Twp.) 12 (Sur. Rge.) 18W Map No.

Operator Petroleum Inc.

Well No. 7 Farm Reeder

Elev.	2149	Location	NW NE SW
-------	------	----------	----------


330 Ft. From N Line SW

990 Ft. From E Line Quarter

1st. Report

Completion MAR 4 1953

Remarks

Garvey - Contr.

Spudding Date 2-17-53

Drig. Data D & A TD 3691

8" @ 195 Heeb. 3363 Tor. 3386

Lans. 3408 DST 3482-3525 open 1 hr.

Rec. 250' muddy gcsw 1035# TD 3691

D. & A.

J. G. McGEHEE