


Ellis

KANSAS

SECTION 22 TOWNSHIP 12S RANGE 18W

WELL NO. #9 Reeder

COMPANY Petroleum Inc.

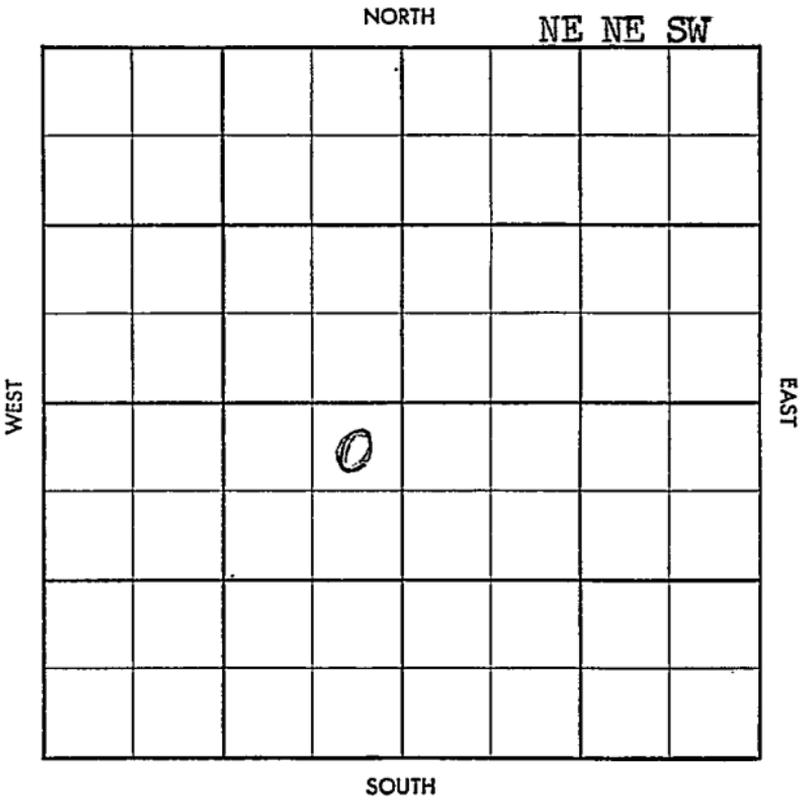

~~Pool~~
~~Pool~~

S-513-B

County Ellis Elev. 2160.26
 Sec. 22 Twp. 12 Rge. 18W
 Company Petroleum Inc.
 Farm Name Reeder No. 9

TOPS	DEPTH	LOG	DATUM
Anh.	1395		
Tp.	3153		
H.	3387		
Tr.	3409		
Dg.			
B.L.			
L.	3434		
K.C.			
B.K.C.	3673		
Ce.			
C.	3693		
M.			
M.			
K.			
Mz.			
Mq.			
V.			
S.			
S.			
A.			
R.			
Pf.			
G.			
T.D.	3755		

Loc. in Sec. NE NE SW
 Geol. _____
 Contr. _____
Garvey #11
 Pool Koblitz

ABANDONED
 0
 APR 16 58

Date Comm. 4/7/58
8" @ 235, Drlg. 2360. APR 1 12 DST 3461-3528
1 1/2 12' M BHP 562/15" NO LOG

D&A

Co.
Lsg.
No.
Sec.
T.
R.