


Section 22 Township 12 Range 18-W

Well No. #1 Redder

Company Petroleum Inc.
Koblitz Pool

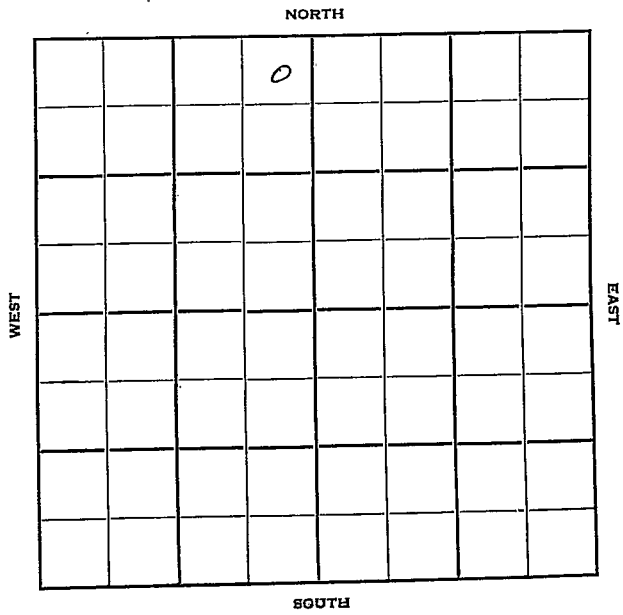

Sec. 22 Twp. 12 R. 18W

Well No. #1 Redder Farm

Petroleum, Inc. Company

Koblitz Pool


330' Ft. from N. Line

 Ft. from S. Line

330' Ft. from E. Line

 Ft. from W. Line

NE NW

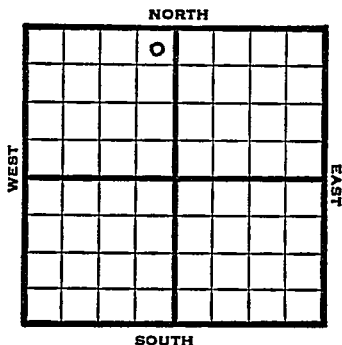

1949

Elev. 2171' REPORT

11/30

RUR

12/7

8" @ 208'

Drlg 3173'

12/14

Lans. 3430'

Arb 3716'

TD 3721'

ABANDONED

Map No. _____ Sec. 22 Twp. 12 R. 18W

Well No. 1 Redder

_____ Petroleum Inc. _____ Company

_____ Contractor

NE NW


FIRST REPORT
SECTION PLAT

330 Ft. from N. Line

_____ Ft. from S. Line

330 Ft. from E. Line

_____ Ft. from W. Line

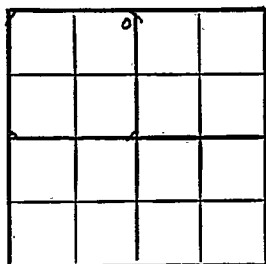

Ellis County

Location _____

Rig up _____

Drilling and Remarks:

R U R

RECORD

Cased _____ in., _____ ft.

Sand _____

Gas _____

Oil _____

Total Depth _____

PRODUCTION

1st 24 hrs. Nat. _____

1st 24 hrs. after shot _____

Gas _____ Cu. Ft.

Dry Hole _____

Abandoned _____

Date

NOV 30 1949

19

S. J. LEWIS

Scout

Kansas

Koblitz Pool

Map No. _____ Sec. 22 Twp. 12 R. 18WWell No. 1 Redder

Petroleum Inc.

Company

ABANDONED

Contractor


NE NW

E1.2771
SECTION PLAT330 Ft. from N. Line

_____ Ft. from S. Line

330 Ft. from E. Line

_____ Ft. from W. Line

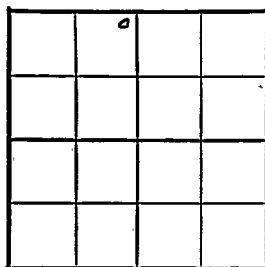

Ellis County

Location _____

Rig up _____

Drilling and Remarks:

Ham 3430CR 3716

RECORD

Cased _____ in., _____ ft.

Sand _____

Gas _____

Oil _____

Total Depth 3721

PRODUCTION

1st 24 hrs. Nat. _____

1st 24 hrs. after shot _____

Gas _____ Cu. Ft.

Dry Hole _____

Abandoned _____

Date

DEC 14 1949 19

S. J. LEWIS Scout