

KANSAS


FORM 51 5M 1-42 PETROL

Ellis

Section 22 Township 12 Range 18 W

Well No. 1 Reeder

Company Doley Oil

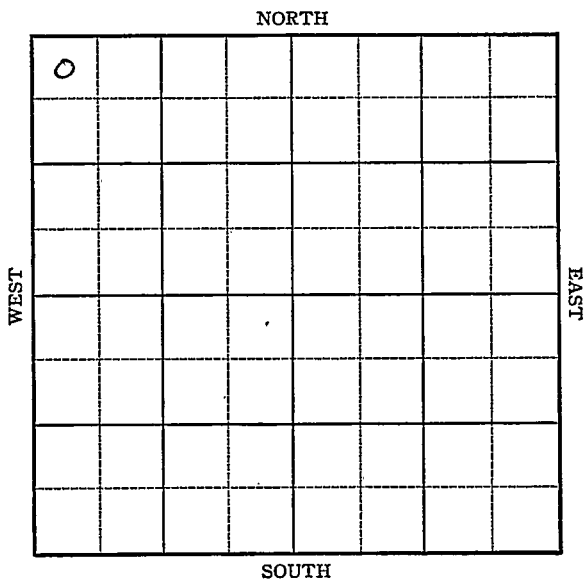

Sec. 22 Twp. 12 R. 18-W

Well No. #1 Reeder Farm

Doley Oil Company


330 Ft. from N. Line

Ft. from S. Line

Ft. from E. Line

330 Ft. from W. Line

Elev. 2148

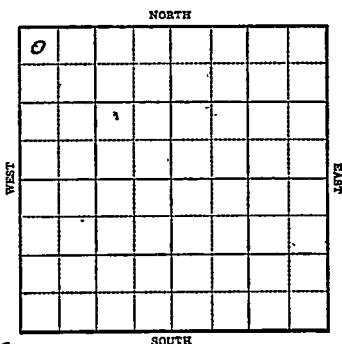

R E P O R T

1943

11/17	Location.
11/24	"
12/1	"
12/8	"
12-15	"
12/22	"
12/29	"
1944	
1-5	"
1-12	"
1/19	"
1/26	8" @ 142 WOC.
2/2	Anhy 1440 Drlg. 2600
2/8	Topeka 3130 Dodge 3404 Lans 3424 Drlg. 3577
2/16	Cong 3696 Simp 3784 Arb 3796 TD 3824

ABANDONED

KANSAS

Map No. 7/ Sec. 22 Twp. 12 R. 18WWell No. 1 ReederDoley Oil

Company

FIRST REPORT

Contractor

NW/C

SECTION PLAT

330


Ft. from N. Line

Ft. from S. Line

Ft. from E. Line

330

Ft. from W. Line

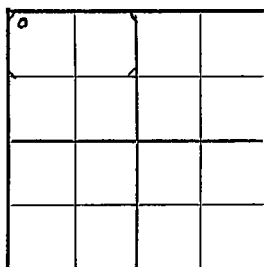

Walters Pool

Location X

Rig up

Drilling and Remarks:

RECORD

Cased _____ in., _____ ft.

Sand _____

Gas _____

Oil _____

Total Depth _____

PRODUCTION

1st 24 hrs. Nat. _____

1st 24 hrs. after shot _____

Gas _____ Cu. Ft.

Dry Hole _____

Abandoned _____

Date

NOV 17 1943

19

S. J. LEWIS

Scout

KANSASMap No. 77 Sec. 22 Twp. 12 R. 18WWell No. 1 ReederDoley Oil

Company

ABANDONED

Contractor

NW/C

SECTION PLAT

330


Ft. from N. Line

Ft. from S. Line

Ft. from E. Line

330

Ft. from W. Line

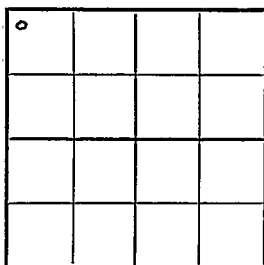Walters Pool

Location

Rig up

Drilling and Remarks:

*Cong 3696**Sump 3784**Per 3796*

RECORD

Cased _____ in., _____ ft.

Sand _____

Gas _____

Oil _____

Total Depth 3824

PRODUCTION

1st 24 hrs. Nat. _____

1st 24 hrs. after shot _____

Gas _____ Cu. Ft.

Dry Hole _____

Abandoned _____

Date

FEB 16 1944

19

S. J. LEWIS

Scout