


Section 22 Township 12 Range 18W

Well No. #3 Reeder

Company Petroleum Inc.

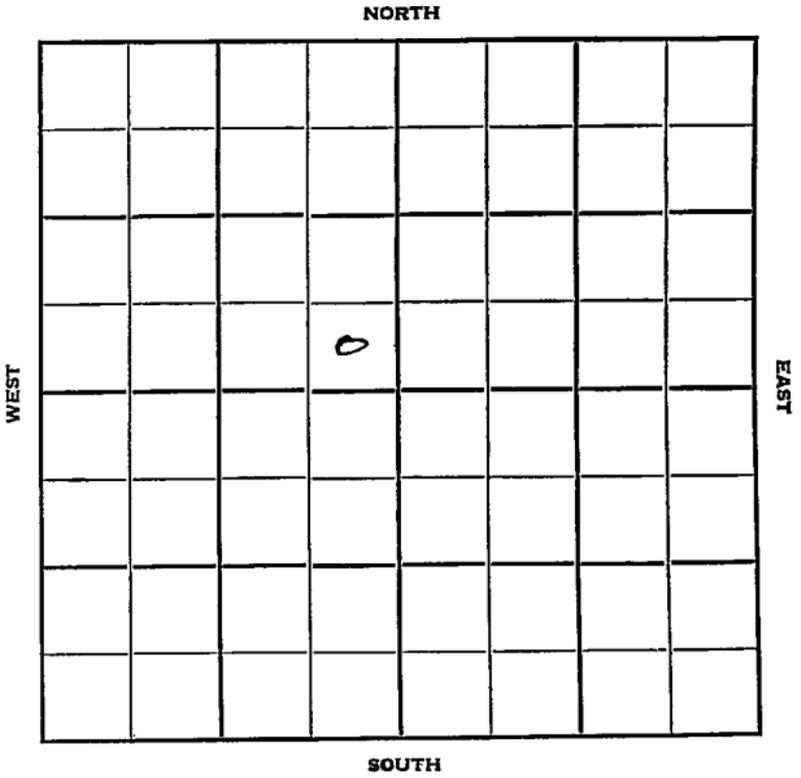

Sec. 22 Twp. 12 R. 18 W

Well No. # 3 Reeder Farm

Petroleum Inc. Company

Contractor


_____ Ft. from N. Line

330 Ft. from S. Line

330 Ft. from E. Line

_____ Ft. from W. Line

SE SE NW

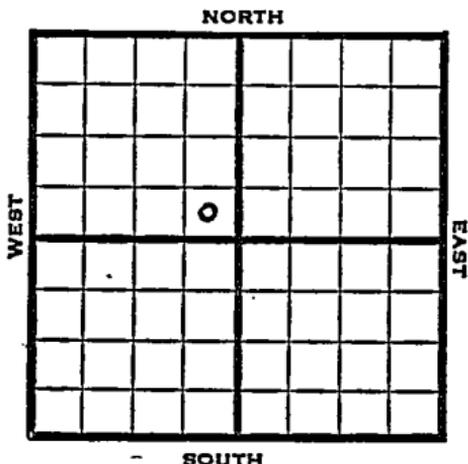

1952

Elev. 2154' REPORT

1/9

Spud 12-29-51
Drilling

2/6

RTD 3720
5" @ 3719, DP

2/13

Spud 12-29-51
Oil Well TD 3720
8" @ 200 Heeb. 3365
Tor. 3388 Lans. 3412
DST 3430-69 open 45 min. rec. 20' mud
DST 3467-3511 open 2 hr. rec.
1230' mud & wtr. 1230' muddy oil &
GCW. 50% oil 150' wtr.
DST 3546-3611 open 45 min. rec. 25'
mud Arb. 3670
DST 3671-74 open 75 min. rec. 30'
HOCM TD 3720 5" @ 3719
32/ 3676-80 S/ 4 boph 6 hr.
30% wtr. Comp. 50 bopd
30% wtr.

COMPLETED

