

FORM 51


Ellis

KANSAS

Section 22 Township 12 Range 18W

Well No. #6 Reider

Company Petroleum Inc.,

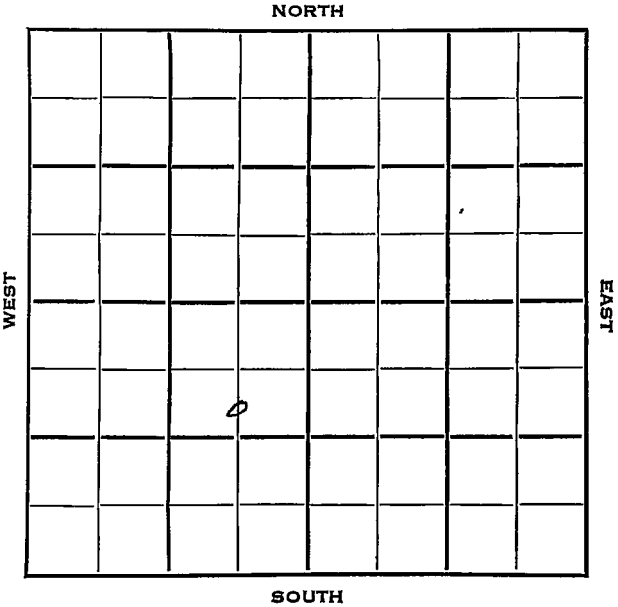

Ellis

KANSAS

Sec. 22 Twp. 12 R. 18WWell No. #6 Reider FarmPetroleum, Inc.

Company

Petr. Inc.

Contractor

Koblitz Pool990

Ft. from N. Line


Ft. from S. Line

660

Ft. from E. Line

Ft. from W. Line

C S L NE SW

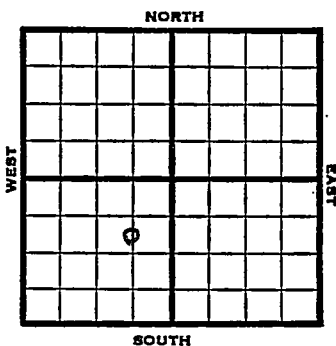

1953

Elev. 2158' REPORT

1/28

Spud 1-23-53

8" @ 200

Anhy 1409

Drlg. 2332

2/5

Heeb 3355' Tor 3377' Lans. 3398'

DST 3480-87', 1 hr, 67' hvly OCM

1010# Arb. 3656'

Drlg.

2/12

RTD 3670' 5" @ 3662 CO 3670

S/10 BOPH

2/19

NR

2/25

Spud 1-23-53 Oil well TD 3670

8" @ 200 Anhy 1409 Heeb 3355

Tor 3377 Lans 3398

DST 3480-87 open 1 hr. rec 67' HO CM

1010# Arb. 3656 TD 3670

5" @ 3662 CO to 3670 S/10 BOPH

DST 3413-48 open 1 hr, rec 405' oil
930#

Comp. 50 BOPD

COMPLETE

County Ellis State Kansas

Sec. 22 (Blk. Twp.) 12 (Sur. Rge.) 18W Map No.

Operator Petroleum Inc.

Well No. 6 Farm Reider

Elev.	Location	C S L NE SW
FIRST REPORT

990 Ft. From N Line SW

660 Ft. From E Line Quarter

1st. Report JAN 28 1953

Completion


Remarks

Pet. Inc. - Contr.

Spudding Date **1-23-53**

Drlg. Data Koblitz Pool

8ⁿ @ 200 Anhy 1409 drlg. 2332

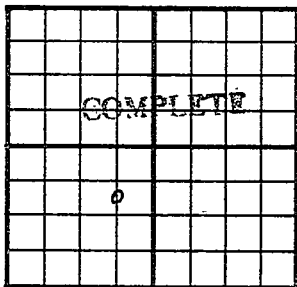County Ellis State KansasSec. 22 (Blk.
Twp.) 12 (Sur.
Rge.) 18W Map No.Operator Petroleum Inc.Well No. 6 Farm ReederElev. 2158 Location C S L NE SW990 Ft. From N Line SW660 Ft. From E Line Quarter

1st. Report

Completion FEB 25 1953Remarks Koblitz PoolPet. Inc. - Contr.Spudding Date 1-23-53Drlg. Data Oil well TD 36708" @ 200 Anhy 1409 Heeb. 3355Tor. 3377 Lans. 3398 DST 3480-87open 1 hr. Rec. 67' hocm 1010#Arb. 3656 TD 3670 5" @ 3662CO to 3670 S/ 10 boph DST 3413-48open 1 hr. Rec. 405' oil 930#Comp. 50 bopd