


Section 23 Township 12 Range 18W

Well No. #3 Byers

Company Carl Lebsack

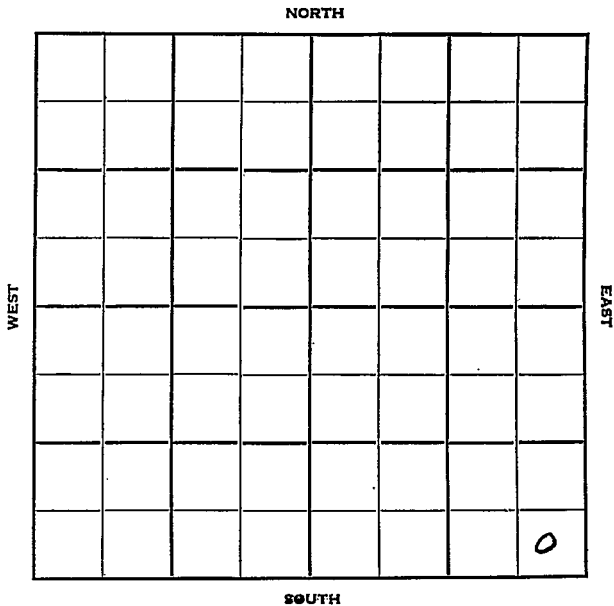

Sec. 23 Twp. 12 R. 18W

Well No. #3 Byers Farm

Carl Lebsack Company


Glenn Nye - Contr. Contractor

_____ Ft. from N. Line

340' Ft. from S. Line

350' Ft. from E. Line

_____ Ft. from W. Line

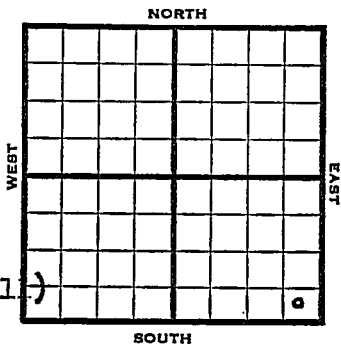

SE SE SE (Twin Well)

1952	Elev. 2130' REPORT
7/2	Spud 6-30-52
7/9	8" @ 175 Anhy 1338 Drlg. 3200'
7/17	Arb. 3640 RTD 3645 5" @ 3644
7/23	Lans. 3370 Perf. in KC S/ 6 Boph nat. POP
7/30	NR
8/6	"
8/13	"
8/20	"
8/27	"
9/4	Spud 6-30-52 Oil Well TD 3645' 8" @ 175' Anhy 1338 Lans. 3370 Arb. 3640 TD 3645' 5" @ 3655 38/ 3464-74 S/ 6 boph Comp. 144 bopd

COMPLETED

County Ellis State KansasSec. 23 (Blk. Twp.) 12 (Sur. Rge.) 18W Map No.Operator Carl LebsackWell No. 3 Farm ByersElev. 2130 Location SE SE SE (twin well)

									0

340 Ft. From S Line SE350 Ft. From E Line Quarter

Ist. Report _____

Completion SEP 4 1952

Remarks _____

Glenn Nye - Contr.Spudding Date 6-30-52Drlg. Data Oil well TD 36458" @ 175 Anhy 1338 Lans. 3370Arb. 3640 TD 3645 5" @ 364438/ 3464-74 S/ 6 bophComp. 144 bopd