
FORM 51

Ellis KANSAS

Section 23 Township 12 Range 18 W

Well No. # 5 Byers

Company Lebsack

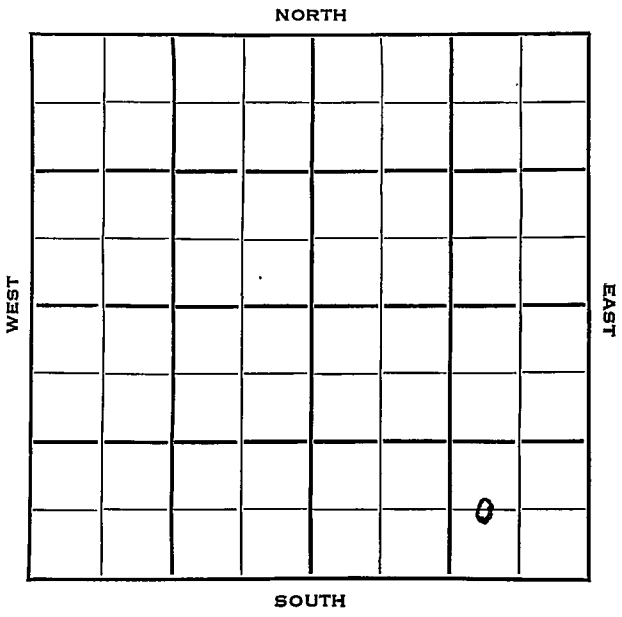

FORM 252-B

Ellis KANSAS

Sec. 23 Twp. 12 R. 18W ✓

Well No. #5 Byers Farm

Lebsack Company

Contractor


Ft. from N. Line

660 Ft. from S. Line

990 Ft. from E. Line

Ft. from W. Line

C W L SE SE

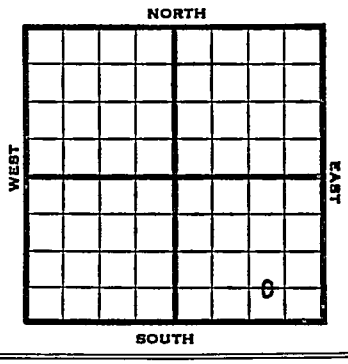

1953	Elev. 2100' REPORT
7/22	Spud 7-15-53
7/29	Drlg.
8/5	NR
8/19	8" @ 158 Anhy 1307 Drlg. 1789'
8/26	Drlg.
9/2	RTD 3620' 5" @ 3618'
9/9	NR
9/23	"
10/7	P/250 BOPD
10/14	Spud 8-13-53 Oil Well TD 3639' 8" @ 158' Anhy 1307', Heeb 3305', Lans 3350' DST 3365-3450', opn 1/2 hrs., rec. 540' gas, 240' hgcm, 180' gco, 500# Simp. 3602, Arb. 3616 TD 3639, 300A S/7 boph 10 hrs. P/250 bopd Comp. 87 bopd

COMPLETED

FORM 275 FOR SALE BY KANSAS BLUE PRINT CO.


County Ellis State Kansas

Sec. 23 (Blk. Twp.) 12 (Sur. Rge.) 18W Map No.

Operator Lebsack

Well No. 5 Farm Byers

Elev. Location C W L SE SE

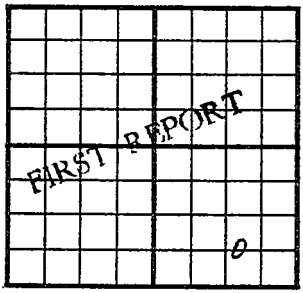

660 Ft. From S Line SE

990 Ft. From E Line Quarter

1st. Report JUL 22 1953

Completion

Remarks

Spudding Date 7-15-53

Drlg. Data

J. G. McGEHEE

FORM 275 FOR SALE BY KANSAS BLUE PRINT CO.


County Ellis State Kansas

Sec. 23 (Blk. Twp.) 12 (Sur. Rge.) 18W Map No.

Operator Lebsack

Well No. 5 Farm Byers

Elev. 2100 Location C.W L SE SE

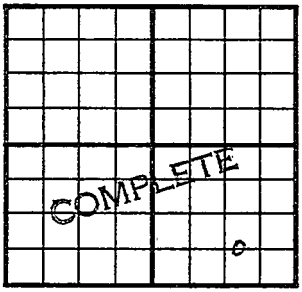

660 Ft. From S Line SE

990 Ft. From E Line Quarter

1st. Report

Completion OCT 14 1953

Remarks Glenn Nye - Contr.

Spudding Date 8-13-53

Drlg. Data Oil well TD 3639

8" @ 158 Anhy 1307 Heeb. 3305

Lans. 3350 DST 3365-3450 open ½ hr.

Rec. 540' gas 240' hgcm 180' gco

500# Simp. 3602 Arb. 3616 TD 3639

300 A S/ 7 boph 10 hr. P/ 250 bopd

Comp. 87 bopd

J. G. McGEHEE