


DX 78-1

Ellis KANSAS

Section 23 Township 12 Range 18W

Well No. 5 Byers "B"

Company Carl Lebsack

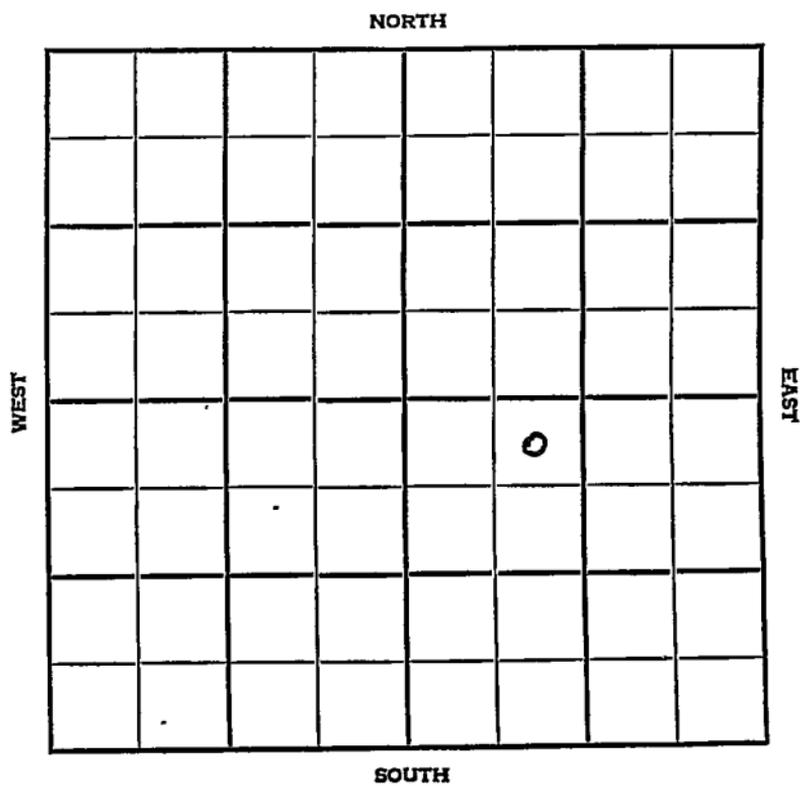

# Ellis

SEC. 23	TWP. 12	R. 18W
---------	---------	--------

**KANSAS**

WELL NO. #5 Byers "B" FARM

COMPANY Carl Lebsack

CONTRACTOR Isern Drlg. Tools.


Koblitz Pool

330 \_\_\_\_\_ Ft. from N. Line

\_\_\_\_\_ Ft. from S. Line

\_\_\_\_\_ Ft. from E. Line

990 \_\_\_\_\_ Ft. from W. Line

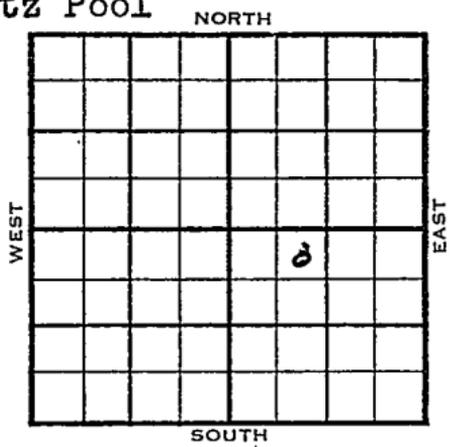

NE NW SE

	ELEVATION	REPORT
1954	2119' DF	
9/29	Spud 9-23-54 8" @ 188'	Anhy 1334' Drlg. 2788'
11/10	Spud 9-23-54 - Oil Well TD 3666' 8" @ 188'	Anhy 1334', Heeb 3332', Lans 3378' DST 3439-83', opn 1/2 hrs., rec. 15' mud, 560# Arb. 3655' DST 3656-66', opn 1/2 hrs., rec. 10' OCM, 5 1/2" @ 3658' CO to 3665', 500A S/5 to 6 boph C omp. 25 bopd 28% wtr.

**COMPLETED**



