


Section 23 Township 12 Range 18-W

Well No. #1 Stackhouse

Company L. W. Wentz & Phillips

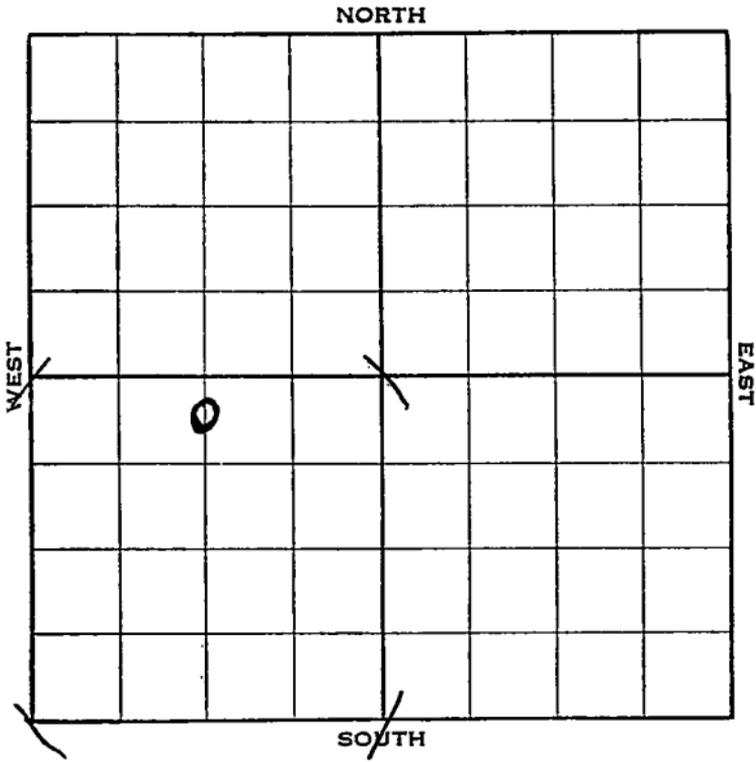

Sec. 23 Twp. 12 R. 18W

Well No. #1 Stackhouse Farm
L. H. Wentz & Phillips Company

C NL SW


330 Ft. from N. Line

_____ Ft. from S. Line

_____ Ft. from E. Line

1320 Ft. from W. Line


Elev. 2159

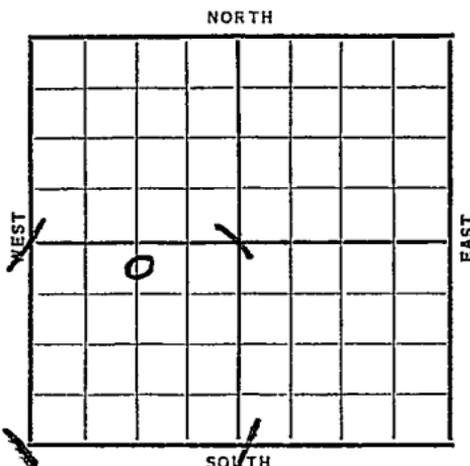

Date	REPORT
1938	
6/29	Location
7/8	15" - 104'. WOC.
7/15	" " "
7/22	Anhy 1412'. 10" - 1423'. Drlg. 3150'.
7/29	Lans. 3405'. Simp. 3660'. Arb. 3677'. T.D. 3679'.
	S. O. Running 7"
8/5	7" - 3677'. Pay 3687-90'. 1800' oil in 20 hrs.
8/10	7" at 3677'.
	Arb. 3677'.
	T. D. 3690'.
	1000 acid.
	Potential 1003 bbls. 1% water.
	COMPLETED

Ellis KANSASMap No. 71 Sec. 23 Twp. 12 R. 18WWell No. 1 StackhouseL. H. Wentz & Phillips Company

Contractor

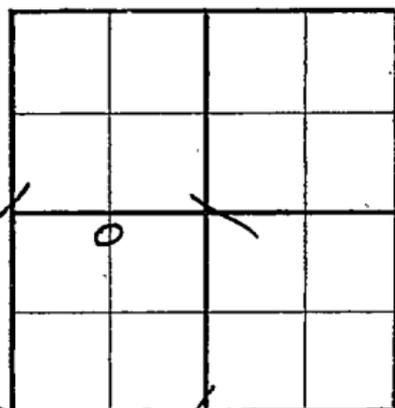FIRST REPORT**C N L SW**330 Ft. from N. Line Ft. from S. Line Ft. from E. Line1320 Ft. from W. Line**SECTION PLAT**Location XRig up Drilling and Remarks: **RECORD**Cased in., ft.Sand Gas Oil Total Depth **PRODUCTION**1st 24 hrs. Nat. 1st 24 hrs. after shot Gas Cu. Ft.Dry Hole Abandoned

Date

JUN 29 1938 19H. D. Hatfield Scout

Map No. 71 Sec. 23 Twp. 12 R. 18W

Well No. 1 Stackhouse

L. H. Wentz & Phillips Company

Contractor

COMPLETED

C N L SW

330 Ft. from N. Line

_____ Ft. from S. Line

_____ Ft. from E. Line

1320 Ft. from W. Line

SECTION PLAT

0			

Location _____

Rig up _____

Drilling and Remarks:

1000 acid

POT 1003

190 w/h

RECORD

Cased 7 in., 3677 ft.

Sand Ab 3677

Gas _____

Oil _____

Total Depth 3690

PRODUCTION

1st 24 hrs. Nat. _____

1st 24 hrs. after shot _____

Gas _____ Cu. Ft.

Dry Hole _____

Abandoned _____

Date

AUG 10 1938

19

Hatfield Scout