

KANSAS


Form 51-5M-7-39-Palace

Ellis

Section 23 Township 12 Range 18-W

Well No. #1 Stackhouse

Company Dolley

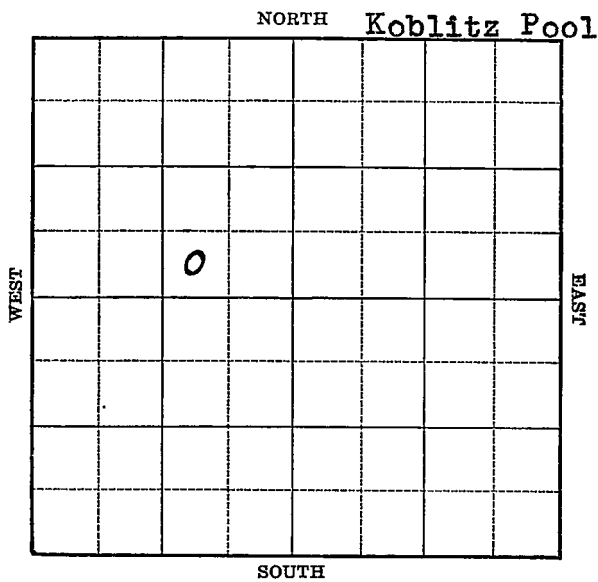

KANSAS

Ellis

Sec. 23 Twp. 12 R. 18-WWell No. #1 Stackhouse FarmDolley Company


(Koblitz)

Ft. from N. Line

330 Ft. from S. Line990 Ft. from E. Line

Ft. from W. Line

Elev. 2169

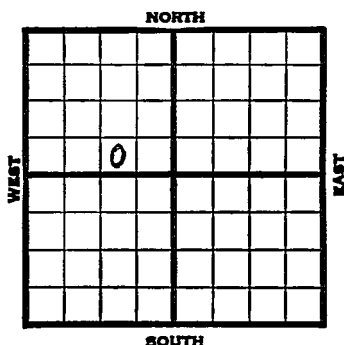

1939

REPORT

9/27

Location

10/5

Rotary.

10/12

"

10/19

"

10/26

"

11/2

Drlg. 160'

11/9

12" - 160' 10" - 1200'

Drlg. 2200'

11/16

Topeka 3132'

Drlg. 3250'

11/22

Rework Arb. 3723' water.

T.D. 3775'

COMPLETED

Ellis KANSAS

Map No. _____ Sec. 23 Twp. 12 R. 18WWell No. 1 StackhouseDolley

Company

Contractor

FIRST REPORT

SW SE NW


_____ Ft. from N. Line

330 Ft. from S. Line990 Ft. from E. Line

_____ Ft. from W. Line

KOBLITZ POOL

SECTION PLAT

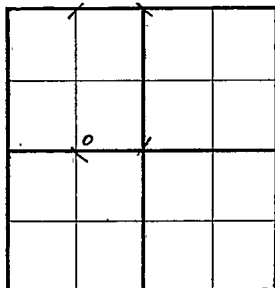Location X

Rig up _____

Drilling and Remarks: _____

RECORD

Cased _____ in., _____ ft.

Sand _____

Gas _____

Oil _____

Total Depth _____

PRODUCTION

1st 24 hrs. Nat. _____

1st 24 hrs. after shot _____

Gas _____ Cu. Ft.

Dry Hole _____

Abandoned _____

Date

SEP 27 1939 19S. J. B.

Scout

Map No. 71 Sec. 23 Twp. 12 R. 18WWell No. 1 StackhouseDolley

Company

Contractor


ABANDONED

SW SE NW

 Ft. from N. Line330 Ft. from S. Line990 Ft. from E. Line Ft. from W. Line

KOBELITZ POOL

SECTION PLAT

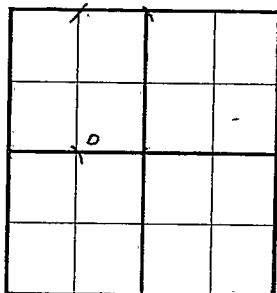Location Rig up

Drilling and Remarks:

*Reworked 8 3723**Water.*

RECORD

Cased in., ft.Sand Gas Oil Total Depth 3775

PRODUCTION

1st 24 hrs. Nat. 1st 24 hrs. after shot Gas Cu. Ft.Dry Hole Abandoned

Date

NOV 22 1939 19

S. J. LEWIS Scout