


Section 23 Township 12 Range 18W

Well No. #2
#6 Koblitz

Company Okmar Oil

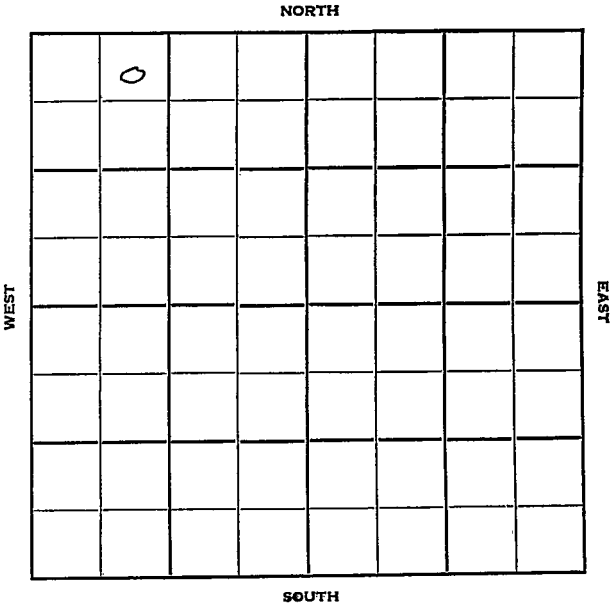

Ellis

KANSAS ✓

Sec. 23 Twp. 12 R. 18 W

Well No. # 6 Koblitz Farm

Okmar Oil

Company

Glenn Nye

Contractor

Koblitz

330

Ft. from N. Line


Ft. from S. Line

Ft. from E. Line

990

Ft. from W. Line

NE NW NW

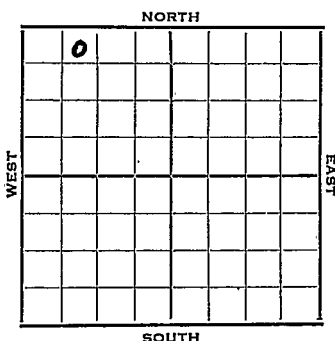

1952

Elev. 2166' REPORT

6/18

Cellar & Pits

6/25

8" @ 169' Anhy 1418'
Drlg. 2995'

7/2

Spud 6-17-52

D&A TD 3720'

8" @ 169' Anhy 1418 Heeb. 3369
Lans. 3419

DST 3480-3550 ppen 1 hr. rec. 95' mud
Cong. 3669 TD 3720' D&A

ABANDONED

County Ellis State KansasSec. 23 (Blk.) 12 (Sur.) 187 Map No.Operator Okmar OilWell No. 6 Farm KoblitzElev. Location NE NW NW

0							

330 Ft. From N Line NW990 Ft. From N Line Quarter1st. Report JUN 18 1952

Completion

Remarks

Glenn Nye - Contr.

Spudding Date


Drig. Data KoblitzCellar & pits

County Ellis State Kansas
 Sec. 23 (Blk.) 12 (Sur.) 18W Map No.

Operator Okmar Oil

Well No. 2 8 Farm Koblitz

Elev. 2166 Location NE NW NW

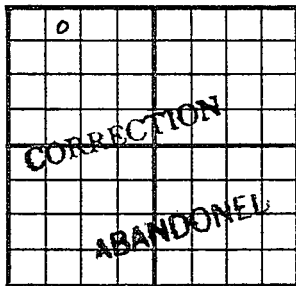

330 Ft. From N Line NW

990 Ft. From W Line Quarter

1st. Report

Completion JUL 2 1952

Remarks Koblitz Pool

Glenn Nye - Contr.

Spudding Date 6-17-52

Drig. Data D & A TD 3720

8" @ 169 Anhy 1418 Heeb. 3369

Lans. 3419 DST 3480-3550 open 1 hr.

Rec. 95' mud Cong. 3669 TD 3720

D & A