

KANSAS

Ellis


FORM 51 5M 4-41 PETROL

Section 23 Township 12 Range 18-W

Well No. #3 Koblitz

Company Doley Oil

NORTH Koblitz Pool

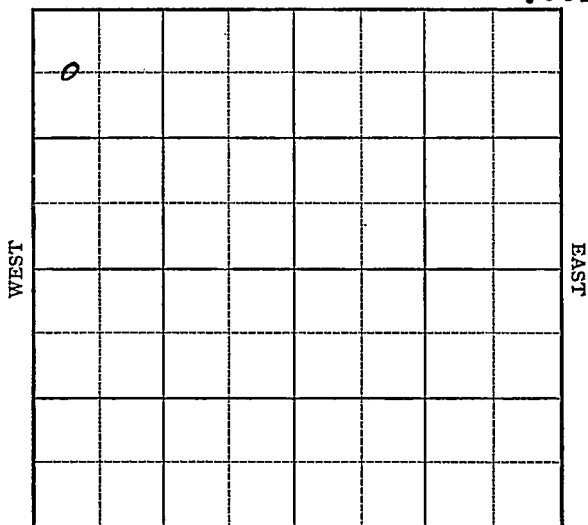


SOUTH

Sec. 23 Twp. 12 R. 18-WWell No. #3 Koblitz FarmDoley Oil Company

(Koblitz)

660 Ft. from N. Line Ft. from S. Line Ft. from E. Line330 Ft. from W. Line

Elev. 2164

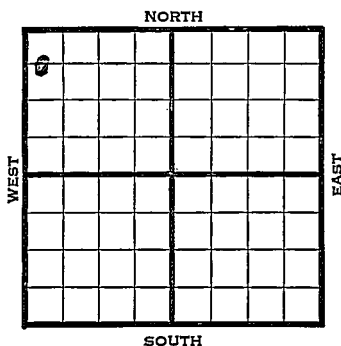

1941	REPORT
4/30	S. H.
5/8	Anhy 1412' 8" - 1248'
	Drlg. 2995'
5/15	Lans. 3510' ^{3410'} Drlg. 3618'
5/22	Lans. 3410' (Corrected)
	Arb. 3672' 5" - 3672'
	T.D. 3677½' 2100' oil.
	1000 acid.
5/28	" "
6/5	" "
6/12	" "
6/18	" "
6/26	" "
7/3	" "
	OVER

1941

7/9

Arb. 3672'

5" - 3672'

T.D. 3677 $\frac{1}{2}$ '

1000 acid.

Depthograph potential 625 oil
plus 12% water.

24. Gravity

COMPLETED

Map No. 71 Sec. 23 Twp. 12 R. 18WWell No. 3 KoblitzDoley Oil

Company

Contractor

FIRST REPORT

C W L NW NW

660 Ft. from N. Line Ft. from S. Line Ft. from E. Line330 Ft. from W. Line

KOBLITZ POOL

SECTION PLAT

6			

Location Rig up

Drilling and Remarks:

S.H.

RECORD

Cased in., ft.Sand Gas Oil Total Depth

PRODUCTION

1st 24 hrs. Nat. 1st 24 hrs. after shot Gas Cu. Ft.Dry Hole Abandoned

Date

APR 30 1941

19

S. J. LEWIS Scout

Map No. _____ Sec. 23 Twp. 12 R. 18WWell No. 3 KoblitzDoley Oil

Company _____

COMPLETED

Contractor _____

SECTION PLAT

C W L NW NW

660 Ft. from N. Line

_____ Ft. from S. Line

_____ Ft. from E. Line

330 Ft. from W. Line

o			

KOBLITZ POOL

Location _____

Rig up _____

Drilling and Remarks:


RECORD

Cased _____ in., _____ ft.

Sand _____

Gas _____

Oil _____

Total Depth 3677 1/2

PRODUCTION

1st 24 hrs. Nat. _____

1st 24 hrs. after shot ✓

Gas _____ Cu. Ft.

Dry Hole _____

Abandoned _____

Date

JUL 9 1941 19 _____ S. J. LEWIS Scout