


Section 23 Township _____ Range 12 18W

Well No. #5 Koblitz

Company Doley Oil

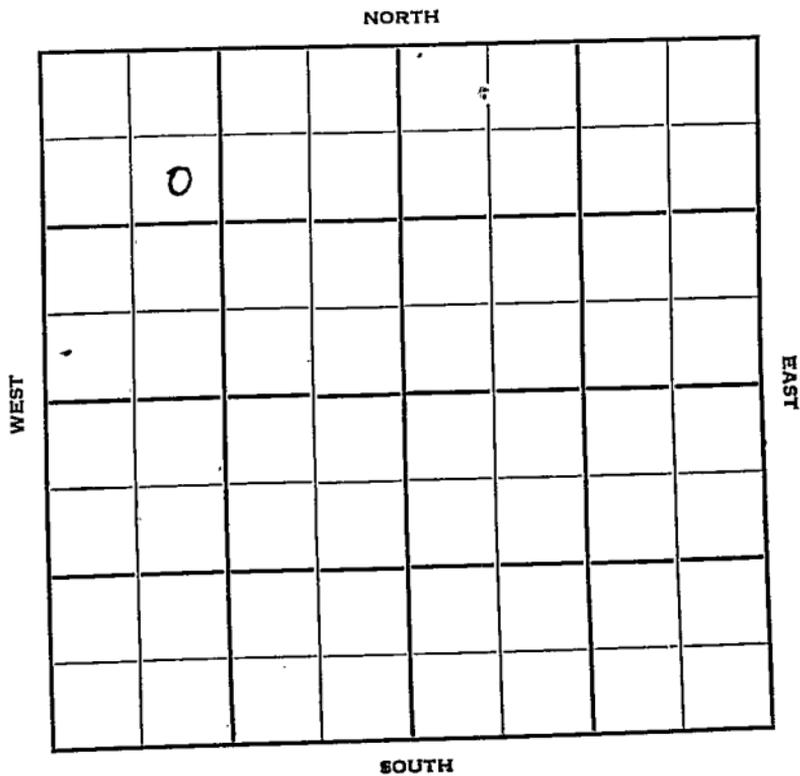

Sec. 23 Twp. 12 R. 18-W ✓

Well No. #5 Koblitz Farm

Doley Oil Company

Walter Contractor


990 Ft. from N. Line

_____ Ft. from S. Line

_____ Ft. from E. Line

990 Ft. from W. Line

SE NW NW

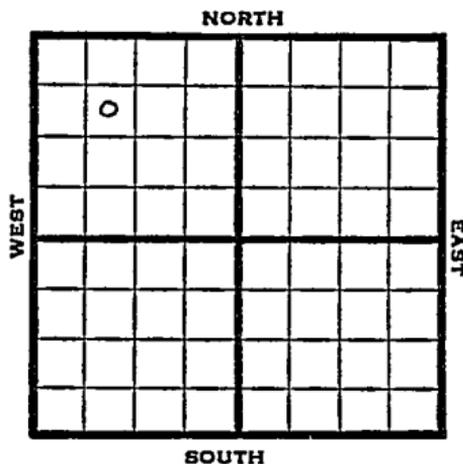

1950 Eley 2168 REPORT

6/7 Spud 6-1-50
8" @ 105

Anhy 1401

Drlg 2675

7/19 8" @ 105

Anhy 1401

KC 3413

Arb 3586

TD 3689

5" @ 3686

DD 3692½

500 acid

S 1¼ boph 8 hr

Comp 30 boph 6% wtr

Completed

COMPLETED

Map No. _____ Sec. 23 Twp. 12 R. 18WWell No. 5 KoblitzDoley Oil Company

Contractor

SE NW NW

SECTION PLAT

990 Ft. from N. Line

_____ Ft. from S. Line

_____ Ft. from E. Line

990 Ft. from W. Line

○			
FIRST REPORT			

Ellis

Location _____

Rig up _____

Drilling and Remarks:

Spud 6-1-50

8" @ 105

Anhy 1401

Drlg. 2675

RECORD

Cased _____ in., _____ ft.

Sand _____

Gas _____

Oil _____

Total Depth _____

PRODUCTION

1st 24 hrs. Nat. _____

1st 24 hrs. after shot _____

Gas _____ Cu. Ft.

Dry Hole _____

Abandoned _____

Date

JUN 7 1950 19J. E. TYRA Scout

~~RECORDED~~Map No. _____ Sec. 23 Twp. 12 R. 18WWell No. 5 KiblitzDoley Oil

Company

Contractor

SE NW NW

E1. 2168
SECTION PLAT990 Ft. from N. Line

_____ Ft. from S. Line

_____ Ft. from E. Line

990 Ft. from W. Line

o			
		COMPLETE	

Ellis County

Location _____

Rig up _____

Drilling and Remarks:

8" @ 105'

Any 1401

KC 3413

Arb. 3586

TD 3689

5" @ 3686

DD 3692 $\frac{1}{2}$

RECORD

Cased _____ in., _____ ft.

Sand _____

Gas _____

Oil _____

Total Depth 3692 $\frac{1}{2}$

PRODUCTION

1st 24 hrs. Nat. _____

1st 24 hrs. after shot _____

Gas _____ Cu. Ft.

Dry Hole _____

Abandoned _____

Date

JUN 19 1950 19J. E. TYRA Scout

500 acid

S 1 1/4 boph 8 hr.

Comp. 30 bopd

6% water
Misc.
Pierce Map
France Map
Tracings
Land Wall Map
Land Small Map
Scout Cards

AUG 1 1930

SECOND

RECEIVED

