

Section 23 Township 12 Range 18 W

Well No. # 1 Stackhouse

Company B & R Drlg.

NORTH

				0			

WEST

EAST

SOUTH

Sec. 23 Twp. 12 R. 18 W

Well No. # 1 Stackhouse Farm

B & R Drlg. Company

B & R Drlg. Contractor

**Koblitz Pool**


990 Ft. from N. Line

\_\_\_\_\_ Ft. from S. Line

\_\_\_\_\_ Ft. from E. Line

330 Ft. from W. Line

SW NW NE

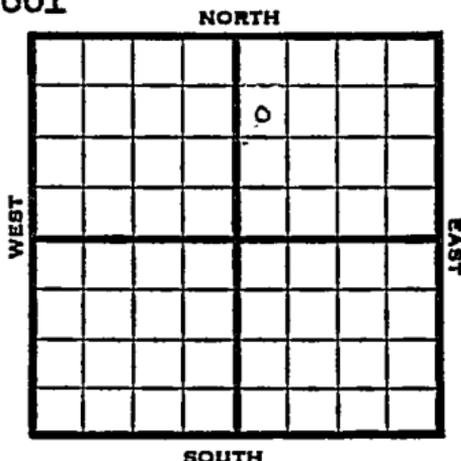

1951

/Elev. 2111' REPORT

5/2

Spud 4-27-51  
8" @ 172 Anhy 1340'  
Drlg. 1940'

5/23

Spud 4-27-51  
Oil well TD 3621' 8" @ 172'  
Anhy 1340' KC 3361'  
DST 3361-3445' open 1 hr. rec 120' mud  
1080' oil & gas, 360' OCM  
Heeb 3292' Lans. 3361' Simp 3592'  
Arb. 3605'  
DST 3580-3621 open 1/2 hr. rec 600' free  
oil, 320' MCO, 90' hvy oil  
5" @ 3621 25/3605-10 500 A  
P/5 BOPH  
Comp. 100 BOPD

**COMPLETED**

**O.W.W.O.**

1951  
9/26

KC 3361 Simp 3592  
Arb. 3605 OTD 3621  
PB 3581 8/3566-73 7/3554-60  
11/3538-48 12/3518-40 12/3502-13  
12/3477-90 8/3453-60 Testing

**OVER**

1951

10/3

Oil well TD 3438'  
KC 3361' Simp. 3592' Arb. 3605'  
OTD 3621' PB 3581' 8/3566-73  
7/3554-60 11/3538-48 12/3518-40  
12/3502-13 12/3477-90 8/3453-60  
12/3442-46 I GO 10 GHPH  
24/3434-38 no inc. SP 3438'  
B/4 BOPH 250 A  
Comp. 75 BOPD

COMPLETED


County Ellis State Kansas

Sec. 23 (Blk. Twp.) 12 (Sur. Rge.) 18W Map No.

Operator B & R Drlg.

Well No. 1 Farm Stackhouse

Elev. \_\_\_\_\_ Location SW NW NE

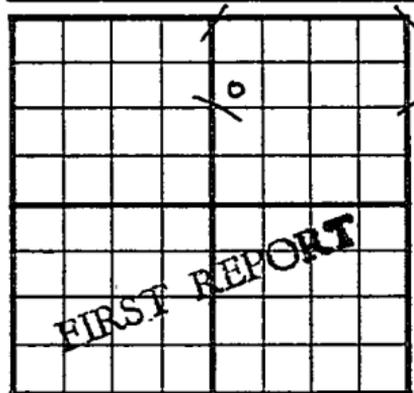

990 Ft. From N Line NE

330 Ft. From W Line Quarter

1st. Report MAY 2 1951

Completion \_\_\_\_\_

Remarks \_\_\_\_\_

B & R Drlg. - Contr.

Spudding Date 4-27-51

Drlg. Data Koblitz Pool

8" @ 172 Anhy 1340 drlg. 1940

J. E. TYRA

County Ellis State KansasSec. 23 (Blk.) 12 (Sur.) 18W Map No.Operator B & R Drlg.Well No. 1 Farm StackhouseElev. 2111 Location SW NW NE


990 Ft. From N Line NE330 Ft. From W Line Quarter1st. ReportCompletion MAY 23 1951Remarks Koblitz PoolB & R Drlg. - Contr.Spudding Date 4-27-51Drlg. Data Oil well TD 36218" @ 172 Anhy 1340 KC 3361DST 3361-3445 open 1 hr. Rec. 120' mud1080' oil & gas 360' ocm Heeb. 3292Lans. 3361 Simp. 3592 Arb. 3605DST 3580-3621 open  $\frac{1}{2}$  hr. Rec. 600' freeoil 320' mco 90' hvy oil 5" @ 362125/ 3605-10 500 A P/ 5 bophComp. 100 bopd

J. E. TYRA



County Ellis State Kansas

Sec. 23 (Blk. Twp.) 12 (Sur. Rge.) 18W Map No.

Operator B & R Drig.

Well No. 1 Farm Stackhouse

Elev. 2111 Location SW NW NE

		0			

990 Ft. From N Line NE

330 Ft. From W Line Quarter

Ist. Report

Completion OCT 3 1951

Remarks OWWO

**O.W.W.O.**

Spudding Date

Drig. Data Oil well TD 3438

KC 3361 Simp. 3592 Arb. 3605 OTD 3621

PB 3581 8/ 3566-73 7/ 3554-60

11/ 3538-48 12/ 3518-40 12/ 3502-13

12/ 3477-90 8/ 3453-60 12/ 3442-46

1 go 10 gwp 24/ 3434-38 no inc.

SP 3438 B/ 4 goph 250 A

Comp. 75 bopd