


Ellis

FORM 51 5M PETROL

Section 23 Township 12 Range 18-W

Well No. #3 Stackhouse

Company Carl Lebsack

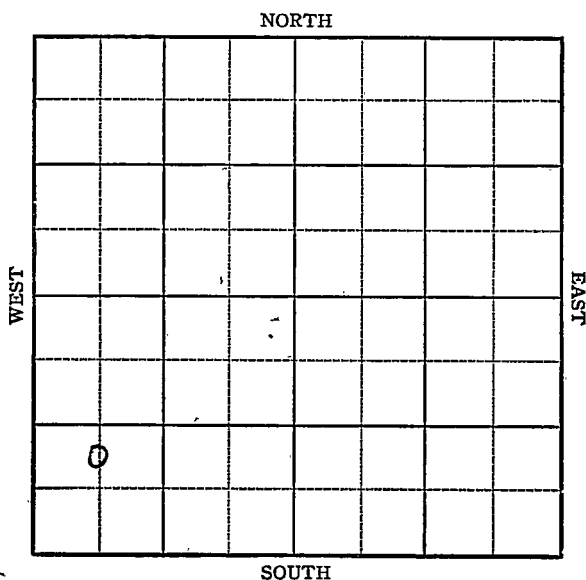

O. W. D. D

Ellis.

Sec. 23 Twp. 12 R. 18-W

Well No. #3 Stackhouse Farm

Carl Lebsack _____ Company


C N E SW SW

Fr. from N. Line

990 Ft. from S. Line

Ft. from E. Line

660 Ft. from W. Line

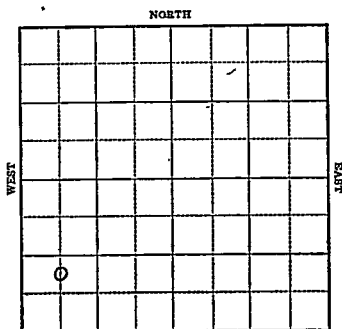

Elev. 2155

SOUTH

1943

REPORT

10/6 | 10" @ 160'

Dr1g. 1200'

10/13 Drlg. 31801

10/20	No report.
-------	------------

10/27 | 5" @ 3688'
Rust

11/3 | Arb 3676

 $5'' @ 3676\frac{1}{2}$

T.D. 3681-500 acid CO

11/10	300' oil 1 hr.
-------	----------------

11/17	SW	& 10	bbls. oil P.H.
-------	----	------	----------------

1/24	"	"	"
------	---	---	---

12/1	"	"	"
------	---	---	---

12/8	12	12
------	----	----

12/15 | 5" @ 3676 $\frac{1}{2}$

Arb 3676

500 acid

Pump 360 Pot.

TD 3681

Gravity 27

COMPLETED

O. W. D. D

OVER

1950 (information brought forward)

7/12 Arb 3673

5" @ 3675

OTD 3681

Was producer

drlg @ 3831 -

for SWD

8/30 Arb 3673

5" @ 3675

OTD 3681

TD 3860

Set 120' of 4" liner @ 3750

Comp for SWD

COMPLETED

KANSAS

Map No. _____ Sec. 23 Twp. 12 R. 18WWell No. 3 StackhouseCarl Lebsack

Company

FIRST REPORT

Contractor

C N L SW SW

SECTION PLAT

o			

_____ Ft. from N. Line

990 Ft. from S. Line

_____ Ft. from E. Line

660 Ft. from W. LineWalters Pool

Location _____

Rig up _____

Drilling and Remarks:

10" - 160
1200

RECORD

Cased _____ in., _____ ft.

Sand _____

Gas _____

Oil _____

Total Depth _____

PRODUCTION

1st 24 hrs. Nat. _____

1st 24 hrs. after shot _____

Gas _____ Cu. Ft.

Dry Hole _____

Abandoned _____

Date

OCT 6 1943

19

S. J. LEWIS

Scout

KANSAS

Map No. 71 Sec. 23 Twp. 12 R. 18WWell No. 3 StackhouseCarl Lebsack

Company

COMPLETED

Contractor

C N L SW SW

SECTION PLAT

o			

Ft. from N. Line

990 Ft. from S. Line

Ft. from E. Line

660 Ft. from W. LineWalters Pool

Location

Rig up

Drilling and Remarks:

*At 3676**5' @ 3676 1/2**500 acid**Prod 360 BT**270 lb*

RECORD

Cased _____ in., _____ ft.

Sand _____

Gas _____

Oil _____

Total Depth 3677

PRODUCTION

1st 24 hrs. Nat. _____

1st 24 hrs. after shot _____

Gas _____ Cu. Ft.

Dry Hole _____

Abandoned _____

Date

DEC 15 1943

19

S. J. LEWIS Scout

Map No. _____ Sec. 23 Twp. 12 R. 18WWell No. 3 Stackhouse_____Carl Lehsack_____
Company_____
Contractor

C N L SW SW

Ft. from N. Line990 Ft. from S. Line_____
Ft. from E. Line660 Ft. from W. Line

SECTION PLAT

0			

Ellis County

Location _____

Rig up _____

Drilling and Remarks:

Arb. 3673

5" C 3675

OTD 3681

Was producer

drlg. @ 3831

for SWD

RECORD

Cased _____ in., _____ ft.

Sand _____

Gas _____

Oil _____

Total Depth _____

PRODUCTION

1st 24 hrs. Nat. _____

1st 24 hrs. after shot _____

Gas _____ Cu. Ft.


Dry Hole _____

Abandoned _____

Date

JUL 12 1950 19J. E. TYRA

Scout

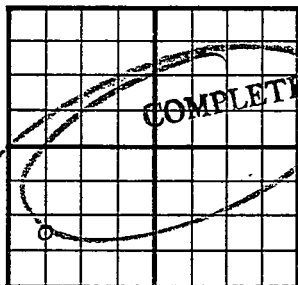County Ellis State KansasSec. 23 (Blk.) 12 (Sur.) 18W Map No.Operator Carl LebsackWell No. 3 Farm StackhouseElev. Location C N L SW SW990 Ft. From S Line SW660 Ft. From W Line Quarter

1st. Report

Completion AUG 30 1950Remarks OWDD

Spudding Date

Drlg. Data SWD well TD 3860Arb. 3673 5" @ 3675 OTD 3681TD 3860 Set 120' of 4" liner @ 3750Comp. for SWD

J. E. TYRA