


Ellis KANSAS

Section 23 Township 12 Range 18 W

Well No. #⁵/₃ Stackhouse

Company Lebsack

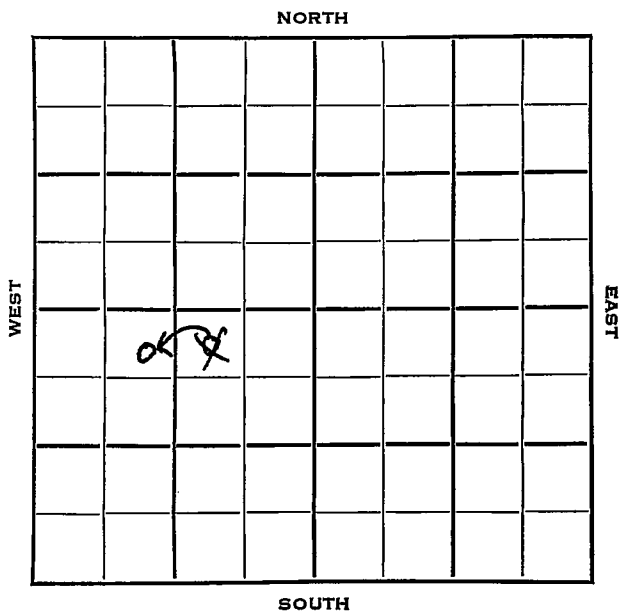

Sec. 23 Twp. 12 R. 18WWell No. #5
#3 Stackhouse FarmLebsack


Company

Nye

Contractor

330 Ft. from N. Line

Ft. from S. Line

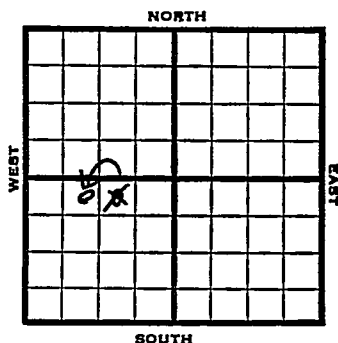-990 Ft. from E. Line1100 Ft. from W. LineNE NW SWNW NE SW

1953 ELEV. 2159' REPORT

4/15 Spud 4-10-53
8" @ 166'
Drlg. 2339'

4/23 Heeb 3369, Lans 3411, Simp 3662
Drlg. 3678

4/30 RTD 3687
5" @ 3685

5/7 Arb. 3683' DD 3688 500 A
S/3 BO plus 15 BWPH DD 3690
PB 3686 250 A S/5 BO plus 10 BWPH

5/21 NR

5/28 "

6/3 "

6/24 P/300 BFPD 3% oil

7/1 NR

7/22 NR

7/29 Spud 4-10-53 D & A TD 3690
8" @ 166 Heeb 3369 Lans 3411
Simp 3662 TD 3687 5" @ 3685
DD 3688 Arb. 3683 500 A S/3 BO
15 BWPH DD 3690 PB 3686 250 A
S/5 BO 10 BWPH P/300 BFPD 3% oil
D & A

ABANDONED

County **Ellis** State **Kansas**

Sec. 23 (Blk. Twp.) 12 (Sur. Rge.) 18W Map No.

Operator **lebsack**

Well No. 3 Farm Stackhouse

Elev.	Location	NW	NE	SW
-------	----------	----	----	----

FIRST REPORT

330 Ft. From N Line SW

990 Ft. From E Line Quarter

1st. Report ' APR 15 1953

Completion

Remarks

Nye - Contr.

Spudding Date 4-10-53

Drlg. Data

8th @ 166 drlg# 2339

~~Revised~~

Map No. _____ Sec. 23 Twp. 12 R. 18W

Well No. 3 Stackhouse

Lebsack **CORRECTION** Company _____

Contractor _____

NE NW SW

SECTION PLAT

330 Ft. from N. Line

_____ Ft. from S. Line

_____ Ft. from E. Line

1100 Ft. from W. Line

0			

Ellis County

Location _____

Rig up _____

Drilling and Remarks:

Reported
NW NE SW

RECORD

Cased _____ in., _____ ft.

Sand _____

Gas _____

Oil _____

Total Depth _____

PRODUCTION

1st 24 hrs. Nat. _____

1st 24 hrs. after shot _____

Gas _____ Cu. Ft.

Dry Hole _____

Abandoned _____

Date

APR 2 1953

19

J. G. McGEHEE Scout

Kansas

Map No. _____ Sec. 23 Twp. 12 R. 18WWell No. 5 Stackhouse

Lebsack _____ Company

CORRECTION

Contractor

NE NW SW

SECTION PLAT

330 Ft. from N. Line

_____ Ft. from S. Line

_____ Ft. from E. Line

1100 Ft. from W. Line

0			

Ellis County

Location _____

Rig up _____

Drilling and Remarks:

Reported
#3 Stackhouse

RECORD

Cased _____ in., _____ ft.

Sand _____

Gas _____

Oil _____

Total Depth _____

PRODUCTION

1st 24 hrs. Nat. _____

1st 24 hrs. after shot _____

Gas _____ Cu. Ft.

Dry Hole _____

Abandoned _____

Date


APR 29 1953

19

J. G. McGEHEE

Scout

County Ellis State Kansas
 Sec. 23 (Blk.) 12 (Sur.) 18W Map No.
 Operator Lebsack
 Well No. 5 Farm Stackhouse
 Elev. 2159 Location NE NW SW

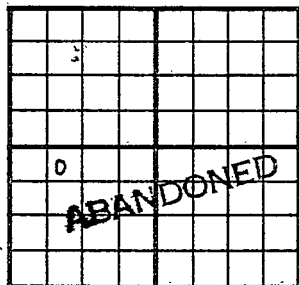

330 Ft. From N Line SW
1100 Ft. From W Line Quarter

1st. Report

Completion JUL 29 1953

Remarks

Nye - Contr.

Spudding Date 4-10-53

Drlg. Data D & A TD 3690

8" @ 166 Heeb. 3369 Lans. 3411

Simp. 3662 TD 3687 5" @ 3685

DD 3688 Arb. 3683 500 A S/ 3 bo

15 bwph DD 3690 PB 3686 250 A

S/ 5 bo 10 bwph P/ 300 bfpd 3% oil

D & A

J. G. McGEHEE