

Section 23 Township 12 Range 18 W

Well No. # 3 Stackhouse (A)

Company B & R Drilling

NORTH

					0		

WEST

EAST

SOUTH

Ellis

KANSAS

Sec. 23 Twp. 12 R. 18W

Well No. #3 Stackhouse (A) Farm

B & R Drlg. Company

Contractor


990' Kabtz  
Ft. from N. Line

Ft. from S. Line

Ft. from E. Line

990' Ft. from W. Line

SE NW NE

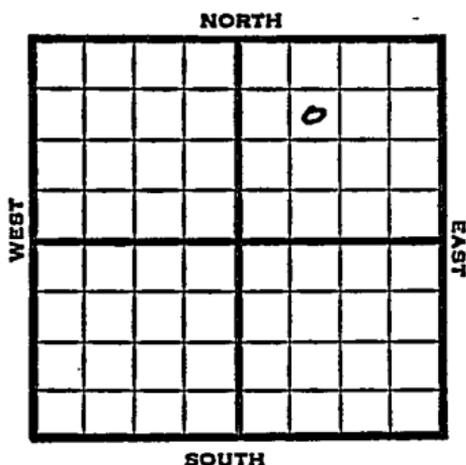

1951 Elev. 2131' REPORT

9/19 Spud 9-16-51  
8" @ 177'

10/10 Oil Well TD 3633  
8" @ 177  
Anhy 1375  
Lans. 3369  
DST 3395-3473 opn 45 min.  
Rec. 1000' ocm 30'  
Simp. 3622'  
Arb. 3631 TD 3633  
5" @ 3631 350 A  
Comp. 50 bopd

**COMPLETED**

County **Ellis** State **Kansas**

Sec. **23** (Blk.) **12** (Sur.) **18W** Map No.

Operator **B & R Drilling**

Well No. **3** Farm **Stackhouse (A)**

Elev. Location **SE NW NE**


**990** Ft. From **N** Line **NE**

**990** Ft. From **W** Line **Quarter**

Ist. Report **SEP 19 1951**

Completion

Remarks

Spudding Date **9-16-51**

Drlg. Data **Kabtz**

**8" @ 177'**

