

KANSAS

Ellis

Section 23 Township 12 Range 18-W

Well No. #1 Slackhouse "A"

Company Doley Oil
Koblitz Pool

NORTH

		o							

SOUTH

Sec. 23 Twp. 12 R. 18W

Well No. 1 Slackhouse "A" Farm

Doley Oil Company


Koblitz Pool Contr. Kline Drlg.

1180 Ft. from N. Line

_____ Ft. from S. Line

_____ Ft. from E. Line

1550 Ft. from W. Line

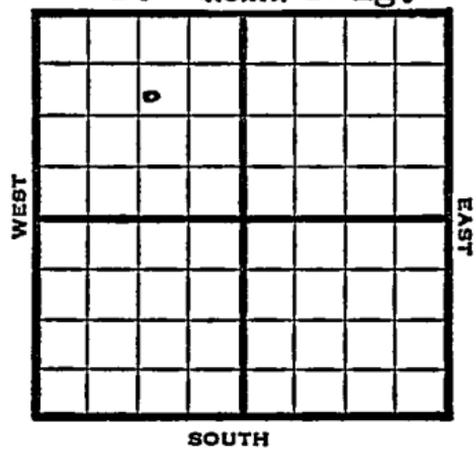

SW NE NW

1949 Elev 2157' REPORT

8/24 8" @ 137'
Anhy 1395'
Drlg 1940'

8/31 Lansing 3403'
Simpson 3660'
Arbuckle 3667'
Drlg. 3710'

9/7 TD 3750'
5" @ 3750'
24 cone shots 3667-73 - 1000 acid
Swb 2 bbls oil & 3 W 1/2 hr.

9/14 Squeeze
16 shots 3670-74
1000 acid

9/21 "

9/28 TD 3750'
Arb. 3607'
5 @ 3750'
Perf 1000 acid
Pump 75 Oil Pot
26° Gr.
Comp

COMPLETED

Map No. _____ Sec. 23 Twp: 12 R. 18W

Well No. 1 Slackhouse "A"

Doley Oil _____ Company

Kline Drlg. _____ Contractor

SW NE NW

FIRST REPORT
SECTION PLAT

	D		

1180 Ft. from N. Line

_____ Ft. from S. Line

_____ Ft. from E. Line

1550 Ft. from W. Line

Ellis County

Location _____

Rig up _____

Drilling and Remarks:

8" @ 137

Anhy 1395

drlg. 1940

RECORD

Cased _____ in. _____ ft.

Sand _____

Gas _____

Oil _____

Total Depth _____

PRODUCTION

1st 24 hrs. Nat. _____

1st 24 hrs. after shot _____

Gas _____ Cu. Ft.

Dry Hole _____

Abandoned _____

Date

AUG 24 1949 19

S. J. LEWIS

Scout

Kansas

Map No. _____ Sec. 23 Twp. 12 R. 18W

Well No. I Stackhouse "A"

Doley Oil Company

COMPLETE

Contractor

SW NE NW

21. 2157
SECTION PLAT

1180 Ft. from N. Line

_____ Ft. from S. Line

_____ Ft. from E. Line

1550 Ft. from W. Line

Ellis County

Location _____

Rig up _____

Drilling and Remarks:

*Act 3667**5" @ 3750**Perf.**1000 acid**Inject 75 oil Perf**26° Gr.*

RECORD

Cased _____ in., _____ ft.

Sand _____

Gas _____

Oil _____

Total Depth *3750*

PRODUCTION

1st 24 hrs. Nat. _____

1st 24 hrs. after shot _____

Gas _____ Cu. Ft.

Dry Hole _____

Abandoned _____

Date

SEP 28 1949 19

S. J. LEWIS Scout