


Section 23 Township 12 Range 18W

Well No. #2 Stackhouse "A"

Company B&R Drlg.

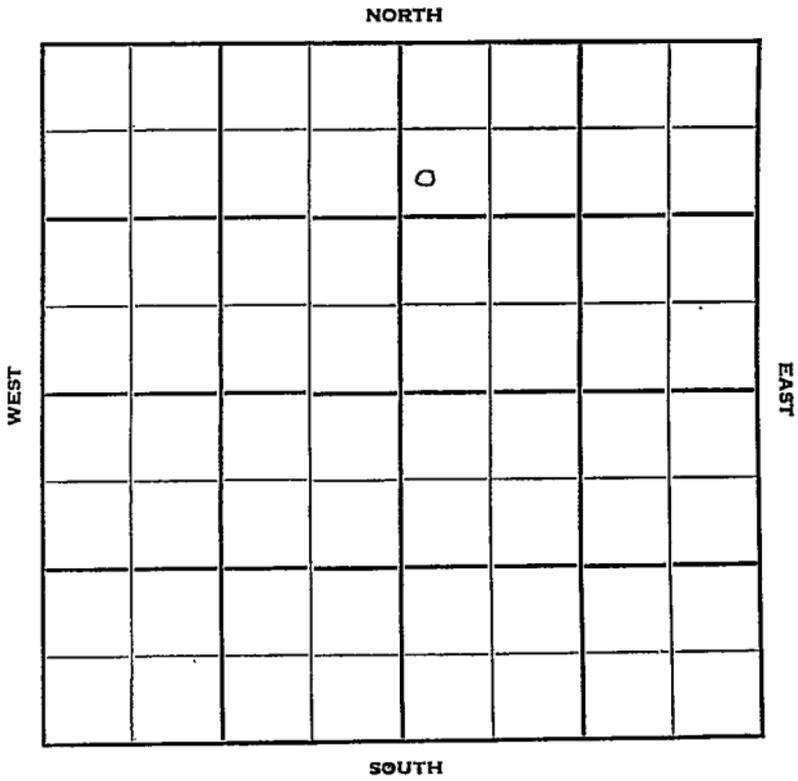

Sec. 23 Twp. 12 R. 18W

Well No. #2 Steckhouse "A" Farm

B & R Drlg. Company

Contractor


Koblitz Pool

990' Ft. from N. Line

Ft. from S. Line

Ft. from E. Line

255' Ft. from W. Line

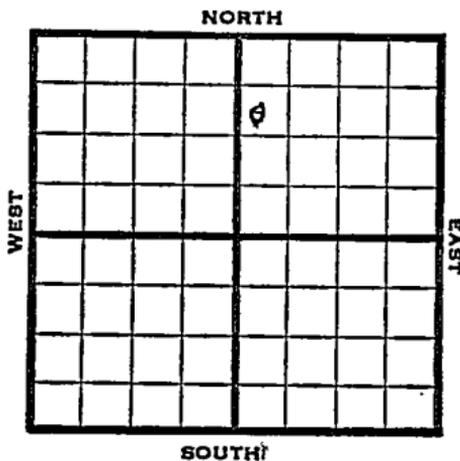

SW NW NE
Twin Well

1951

Elev. 2114' REPORT

9/5

8" @ 194'
Drlg. 937

9/26

Oil Well TD 3613'
8" @ 194'
Anhy 1355'
DST 3265-81' open 1 hr. Rec. 70' ocm
Heeb. 3300 Lans. 3350 Arb. 3612
TD 3613' 12 goph 350 A
Comp. 100 bopd

COMPLETED

