


Section 23 Township 12 Range 18W

Well No. #4 Stackhouse "A"

Company B & R Drlg.

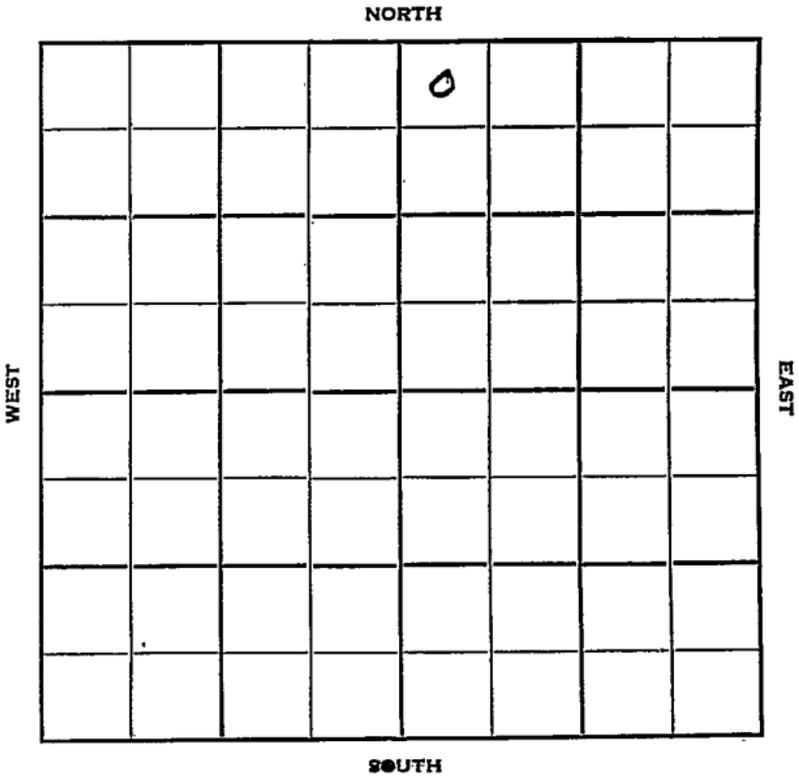

Ellis

KANSAS

Sec. 23 Twp. 12 R. 18W

Well No. #1 Stackhouse "A" Farm

B & R Drlg. Company

Contractor

Koblitz Pool


330 Ft. from N. Line

_____ Ft. from S. Line

_____ Ft. from E. Line

330 Ft. from W. Line

NW NW NE

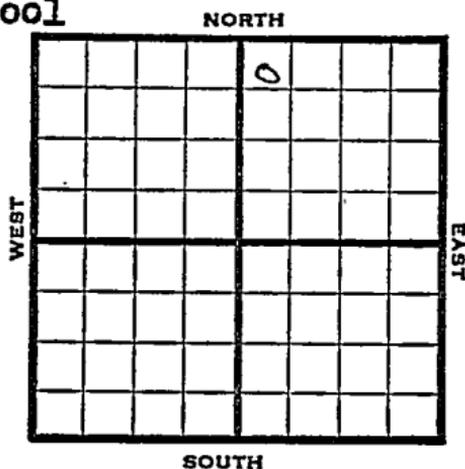

1952 Elev. 2123' REPORT

1/2 Spud 12-24-51
 8" @ 200'
 Anhy 1360'
 Drlg. 2775'

1/23 Spud 12-24-51
 Oil well TD 3623' 8" @ 200
 Anhy 1360' Heeb 3313' Lans. 3360'
 DST 3401-65 open 45 min. rec 2300'
 oil
 Simp. 3612' Arb. 3620-22'
 7" @ 3621 TD 3623' S/3 BOPH
 500 A S/29 BOPH
 Comp. 100 BOPD

COMPLETED

County Ellis State Kansas

Sec. 23 (Blk. Twp.) 12 (Sur. Rge.) 18W Map No.

Operator B & R Drig.

Well No. 4 Farm Stackhouse "A"

Elev. Location NW NW NE

			0		

330 Ft. From N Line NE

330 Ft. From W Line Quarter

1st. Report JAN 2 1952

Completion _____

Remarks _____

Spudding Date 12-24-51

Drig. Data Koblitz Pool

8" @ 200 Anhy 1360 drig. 2775

County Ellis State Kansas

Sec. 23 (Blk. Twp.) 12 (Sur. Rge.) 18W Map No.

Operator B & R Drlg.

Well No. 4 Farm Stackhouse "A"

Elev. 2123 Location NW NW NE

			0		

330 Ft. From N Line NE

330 Ft. From W Line Quarter

Ist. Report

Completion JAN 23 1952

Remarks Koblitz Pool

Spudding Date 12-24-51

Drlg. Data Oil well TD 3623

8" @ 200 Anhy 1360 Heeb. 3313

Lans. 3360 DST 3401-65 open 45 min.

Rec. 2300' oil Simp. 3612 Arb. 3620-22

7" @ 3621 TD 3623 S/ 3 boph 500 A

S/ 29 boph Comp. 100 bopd