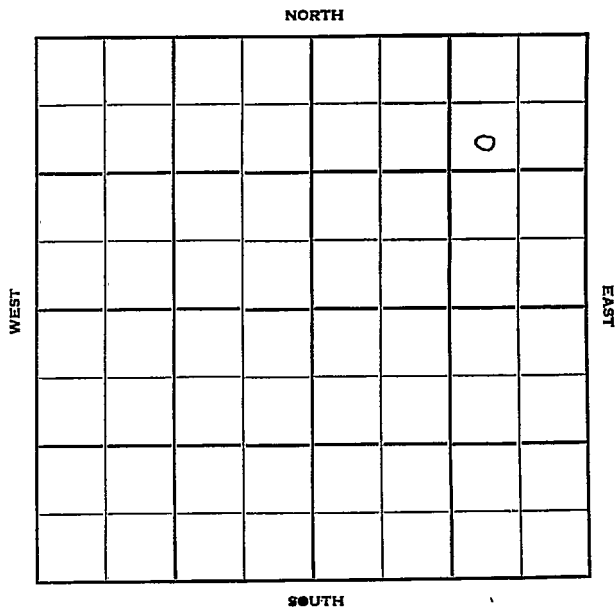


Section 23 Township 12 Range 18WWell No. 7-5 Stackhouse (A)Company B & R Drlg.

Ellis

KANSAS

Sec. 23 Twp. 12 R. 18 W

Well No. # 5 Stackhouse (A) Farm

B & R Drilling Company

Koblitz Contractor


990 Ft. from N. Line

 Ft. from S. Line

990 Ft. from E. Line

 Ft. from W. Line

SW NE NE

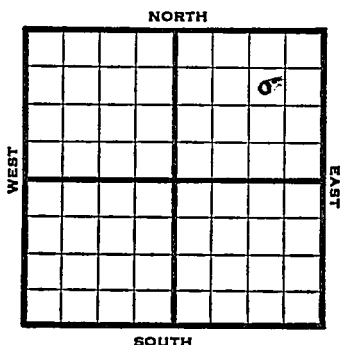

1952

Elev. 2128'

REPORT

1/16

Spud 1-9-52
10" @ 184'
Anhy 1405'
Drlg. 2580'

2/6

TD 4176 7" @ 3790' MICT

2/13

To DD for SWD

2/20

17/3635-39 24/3626-32' dry
Fishing 3792'

3/5

Spud 1-9-52
SWD Well TD 4176
10" @ 184' Anhy 1405'
Heeb. 3333 Lens. 3378
DST 3399-3480 opn 1 hr
Rec. 8' mud Cong. 3633
Simp 3665 Arb. 3675
Gr. Wash 4169 TD 4176
7" @ 3790 17/3635-39 24/3626-32
dry DC 3850 TD 4176 500 A
Comp. for SWD well

ABANDONED

County Ellis State Kansas
 Sec. 23 (Blk. 12 (Sur. 18W Map No. 12)
 (Twp.) (Rge.)

Operator B & R Drilling
 Well No. 5 Farm Stackhouse (A)

Elev. 2128 Location SW NE NE



990 Ft. From N Line NE

990 Ft. From E Line Quarter

Ist. Report JAN 16 1952

Completion

Remarks

Spudding Date 1-9-52

Drlg. Data Koblitz

10" @ 184 Anhy 1405 Drlg. 2580

J. E. TYRA

County	Ellis		State	Kansas	
Sec.	23	(Blk. Twp.)	12	(Sur. Rge.)	18W Map No.
Operator	B & R Drlg.				
Well No.	5	Farm	Stackhouse "A"		
Elev.	2128	Location	SW NE NE		

990 Ft. From	N Line	NE
990 Ft. From	E Line	Quarter
1st. Report		
Completion	MAR 5 1952	
Remarks	Koblitz Pool	

Spudding Date 1-9-52

Drilg. Data SWD well TD 4176

10" @ 184 Anhv 1405 Heeb. 3333

Lans. 3378 DST 3399-3480 open 1 hr.

Rec. 8' mud Cong. 3633 Simp. 3665

Arb. 3675 Gr. wash 4169 TD 4176

7" @ 3790 17/ 3635-39 24/ 3626-32

drv DC 3850 . TD 4176 500 A

Comp. for SWD well