KANSAS

FORM 51 25M 3-49 PETROL Ellis

Section 23 Township 12 Range 18W

Well No. #2 Stackhouse "B"

Company B & R Drlg.

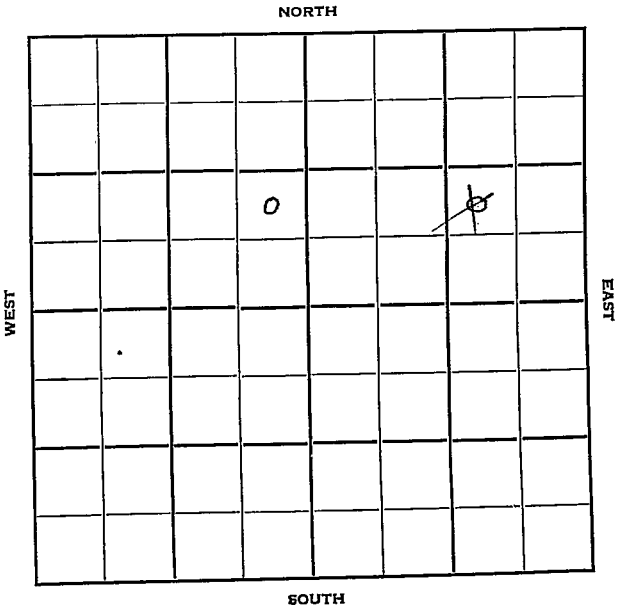

FORM 252-B
10M 11-50 PETROL

Ellis KANSAS

Sec. 23 Twp. 12 R. 18W

Well No. #2 Stackhouse "B" Farm

B & R Drlg. Company

Contractor

Ft. from N. Line

990' Ft. from S. Line

330
990' Ft. from E. Line

Ft. from W. Line

NE NW
~~NW~~ SE ~~NE~~

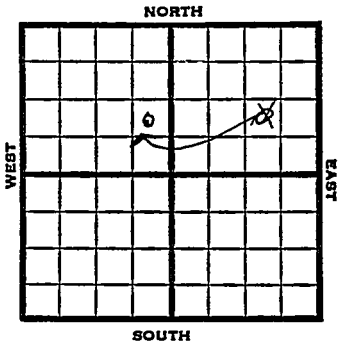

1951	Elev. 2155' REPORT
8/22	Spud 8-17-51 8" @ 166 Drlg. 2270'
9/26	Spud 8-17-51 Oil well TD 3654' 8" @ 166' Anhy 1390 Top. 3176 KC 3390 DST 3416-3500 open 45 min. Rec. 390' ho 7 gcm 180' oil Simp. sh. 3645' Arb. 3649' 5" @ 3650' TD 3654' 500 A Comp. 100 bopd 10% wtr

COMPLETED

FORM 275 FOR SALE BY KANSAS BLUE PRINT CO.

County Ellis State Kansas

Sec. 23 (Blk. Twp.) 12 (Sur. Rge.) 18W Map No.

Operator B & R Drlg.

Well No. 2 Farm Stackhouse "B"

Elev. Location NW SE NE

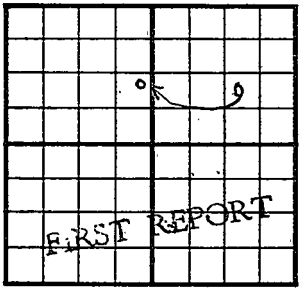

990 Ft. From S Line NE

990 Ft. From E Line Quarter

1st. Report AUG 22 1951

Completion

Remarks see correction

Spudding Date 8-17-51

Drlg. Data

8" @ 166 drlg. 2270

J. E. TYRA

Form 26 200 Bks. 8-50 Petrol

Kansas

Map No. _____ Sec. 23 Twp. 12 R. 18W

Well No. 2 Stackhouse "B"

B & R Drlg. Company

CORRECTION Contractor

NE SE NW

SECTION PLAT

_____ Ft. from N. Line

990 Ft. from S. Line

330 Ft. from E. Line

_____ Ft. from W. Line

Ellis County

Location _____

Rig up _____

Drilling and Remarks:

Reported

NW SE NE

RECORD

Cased _____ in., _____ ft.

Sand _____

Gas _____

Oil _____

Total Depth _____

PRODUCTION

1st 24 hrs. Nat. _____

1st 24 hrs. after shot _____

Gas _____ Cu. Ft.

Dry Hole _____

Abandoned _____

Date

AUG 22 1951 19

J. E. TYRA Scout

FORM 275 FOR SALE BY KANSAS BLUE PRINT CO.

County Ellis State Kansas

Sec. 23 (Blk. Twp.) 12 (Sur. Rge.) 18W Map No.

Operator B & R Drlg.

Well No. 2 Farm Stackhouse "B"

Elev. 2155 Location NE SE NW

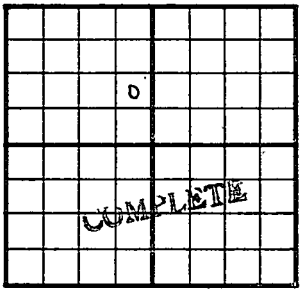

990 Ft. From S Line NW

330 Ft. From E Line Quarter

1st. Report

Completion SEP 26 1951

Remarks

Spudding Date 8-17-51

Drlg. Data Oil well TD 3654

8" @ 166 Anhy 1390 Top. 3176 KC 3390

DST 3415-3500 open 45 min. Rec. 390'

ho & gcm 180'Oil Simp. sh. 3645

Arb. 3649 5" @ 3650 TD 3654

500A Comp. 100 bopd 10% water

J. E. TYRA