

Section 23 Township 12 Range 18 W

Well No. # 3 Stackhouse (B)

Company B & R Drilling

NORTH

			0				

WEST

EAST

SOUTH

Ellis

KANSAS

Sec. 23 Twp. 12 R. 18W

Well No. #3 Stackhouse (B) Farm

B & R Drilling Company

Contractor

Koblitz


330 Ft. from N. Line

_____ Ft. from S. Line

330 Ft. from E. Line

_____ Ft. from W. Line

NE NE NW

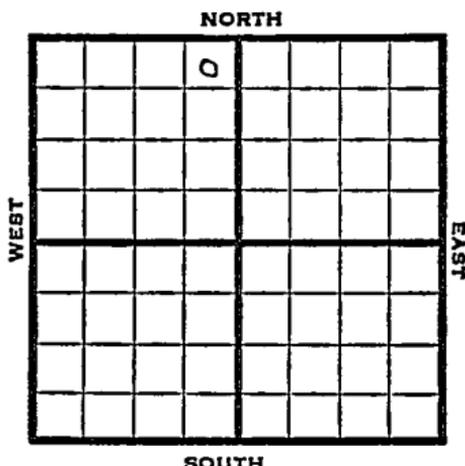

1951

Elev. 2132'

REPORT

10/31

Spud 10-27-51
8" @ 198'
Drlg. 220'

1952
1/2

Spud 10-27-51
Oil Well Td 3632 $\frac{1}{2}$
8" @ 198
Anhy 1365 Heeb. 3324
Lans. 3372 Arb. 3630-32
5" @ 3631 DD 3632 $\frac{1}{2}$
B/ 5 GOPH 250 A S/ 3 BOPH
500 A S/ 25 BOPH
Comp. 100 BOPD

COMPLETED

County Ellis State Kansas

Sec. 23 (Blk. Twp.) 12 (Sur. Rge.) 18W Map No.

Operator B & R Drlg.

Well No. 3 Farm Stackhouse "B"

Elev. 2132 Location NE NE NW

			o			

COMPLETE

330 Ft. From N Line NW

330 Ft. From E Line Quarter

1st. Report

Completion JAN 2 1952

Remarks Koblitz Pool

Spudding Date 10-27-51

Drlg. Data Oil well TD 3632 $\frac{1}{2}$

8" @ 198 Anhy 1365 Heeb. 3324

Lans. 3372 Arb. 3630-32 5" @ 3631

DD 3632 $\frac{1}{2}$ B/ 5 goph 250 A S/ 3 boph

500 A S/ 25 boph Comp. 100 bopd

J. E. TYRA