


Section 23 Township 12 Range 18 W

Well No. # 5 Stackhouse (B)

Company B & R Drlg.

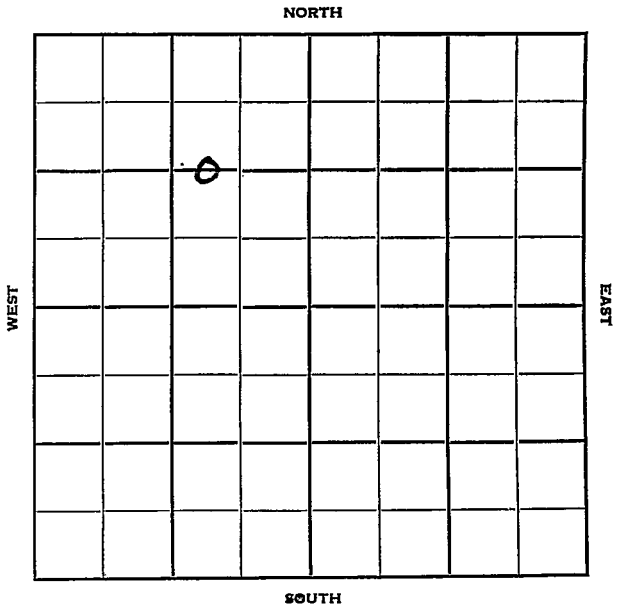

Sec. 23 Twp. 12 R. 18 W

Well No. # 5 Stackhouse (B) Farm

B & R Drlg. Company

B & R Drlg. Contractor


1320 Ft. from N. Line

\_\_\_\_\_ Ft. from S. Line

990 Ft. from E. Line

\_\_\_\_\_ Ft. from W. Line

C W/2 E/2 NW

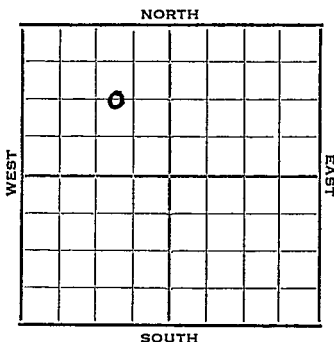

1952

Elev. 2155'

REPORT

4/30

Spud 4-25-52  
10" @ 192'  
Anhy 1390'  
Drlg. 1840'

5/7

Heeb. 3315      Lans. 3400  
DST 3429-3502' 3/4 hr. 400' wtr.  
& m 650# Drlg. 3568'

5/14

Arb. 3663'      RTD 3665'      7" @ 3664  
DP    DD 3667'      28 gal OPH for 24 hrs  
500 A    S/4 BFPN 50% water.

5/21

Spud 4-25-52  
Oil Well TD 3667'      10" @ 192  
Anhy 1390      Heeb. 3315  
Lans. 3400  
DST 3429-3502 open 3/4" hr. rec. 400'  
wtr. & mud      Arb. 3663'  
TD 3665'      7" @ 3664'      DD 3667  
28 goph 500 A      S/ 4 bph  
50% wtr. 1000 A      S/ 10 boph  
Comp. 50 bopd

**COMPLETED**

County Ellis State Kansas

Sec. 23 (Blk. Twp.) 12 (Sur. Rge.) 18W Map No.

Operator B & R Drlg.

Well No. 5 Farm Stackhouse (B)

Elev. 2155 Location C W/2 E/2 NW


1320 Ft. From W Line NW

990 Ft. From E Line Quarter

1st. Report APR 30 1952

Completion \_\_\_\_\_

Remarks \_\_\_\_\_

B & R Drlg. - Contr.

Spudding Date 4-25-52

Drlg. Data

10" @ 192 Anyh 1390 Drlg. 1840

County Ellis State Kansas

Sec. 23 (Blk. Twp.) 12 (Sur. Rge.) 18W Map No.

Operator B & R Drlg.

Well No. 5 Farm Stackhouse "B"

Elev. 2155 Location C W L E  $\frac{1}{2}$  NW


1320Ft. From N Line NW

990Ft. From E Line Quarter

1st. Report

MAY 21 1952

Completion

**COMPLETE**

Remarks

B & R Drlg. - Contr.

Spudding Date 4-25-52

Drlg. Data Oil well TD 3667

10" @ 192 Anhy 1390 Heeb. 3315

Lans. 3400 DST 3429-3502 open 3/4 hr.

Rec. 400' water & mud Arb. 3663 TD 3665

7" @ 3664 DD 3667 28 goph 500 A

S/ 4 bfph 50% water 1000 A S/ 10 boph

Comp. 50 bopd