


Section 23 Township 12 Range 18W

Well No. #4 Stackhouse (B)

Company B & R Drlg.

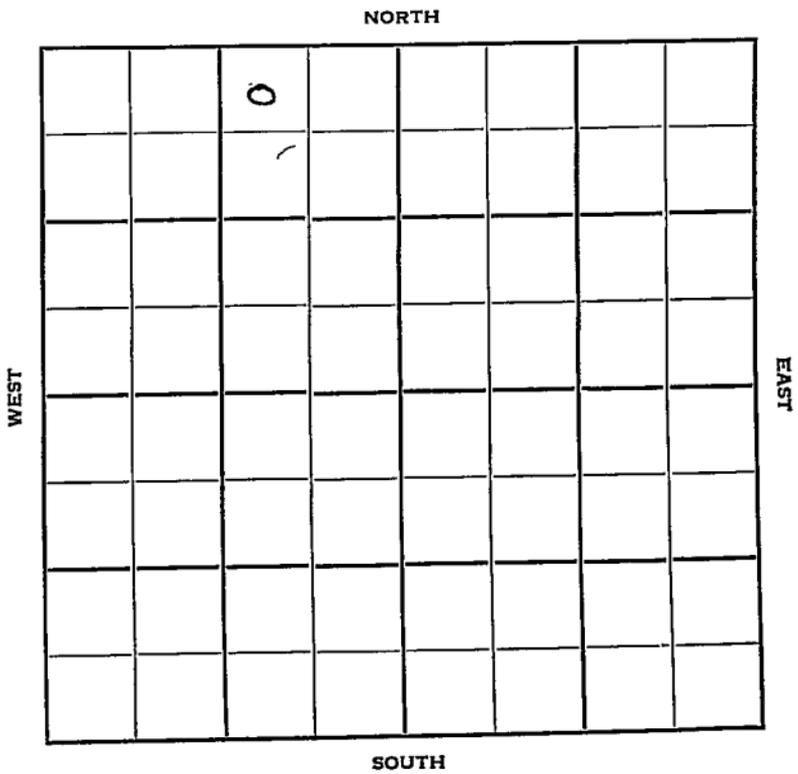

Sec. **23** Twp. **12** R. **18W**

Well No. **#4 Stackhouse (B)** Farm

B & R Drlg. Company

Contractor


330 Ft. from N. Line

Ft. from S. Line

990 Ft. from E. Line

Ft. from W. Line

NW NE NW

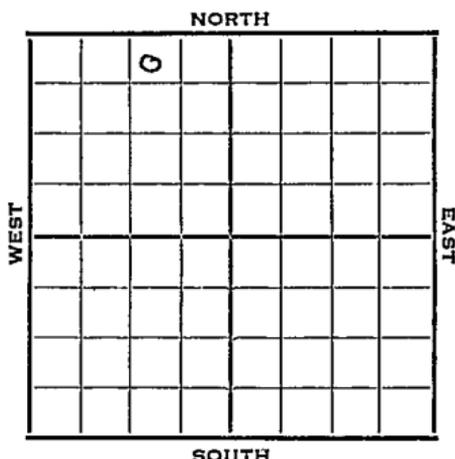

1952 Elev. 2145' / REPORT

4/9 Drlg.

4/23 10" @ 186' Anhy 1375' Heeb 3342'
Lans. 3391' Arb. 3648'
TD 3651' 5" @ 3650'

4/30 CO 3651 S/18 BOPH for 4 hrs.
Tub & Rods

5/7 NR

5/14 NR

5/21 Spud 4-7-52
Oil Well TD 3651' 10" @ 186
Anhy 1375 Heeb. 3342
Lans. 3391 Arb. 3648
TD 3651 5" @ 3650' CO to 3651
S/ 18 boph 4 hr.
Comp. 50 bopd

COMPLETED

County Ellis State Kansas

Sec. 23 (Blk. 12 (Twp. 18W (Sur. 18W Map No.

Operator B & R Drlg.

Well No. 4 Farm Stackhouse "B"

Elev. 2145 Location NW NE NW

		0				

330 Ft. From N Line NW

990 Ft. From E Line Quarter

1st. Report

Completion MAY 21 1952

Remarks

COMPLETE

Spudding Date 4-7-52

Drlg. Data Oil well TD 3651

10" @ 186 Anhy 1375 Heeb. 3342

Lans. 3391 Arb. 3648 TD 3651

5" @ 3650 CO to 3651 S/ 18 boph 4 hr.

Comp. 50 bopd