


Section 23 Township 12 Range 18W

Well No. #6 Stackhouse "B"

Company Trans-Era Pet.

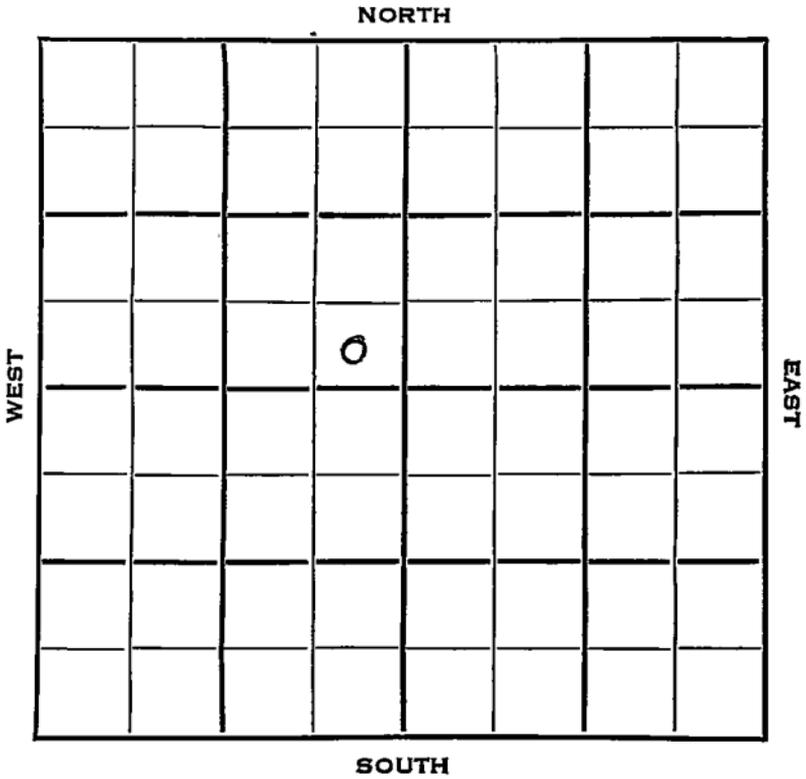

Sec. 23 Twp. 12 R. 18W

Well No. #6 Stackhouse "B" Farm

Trans-Era Pet. Company

Trans-Era Contractor

Koblitz Pool


         Ft. from N. Line

330 Ft. from S. Line

330 Ft. from E. Line

         Ft. from W. Line

SE SE NW

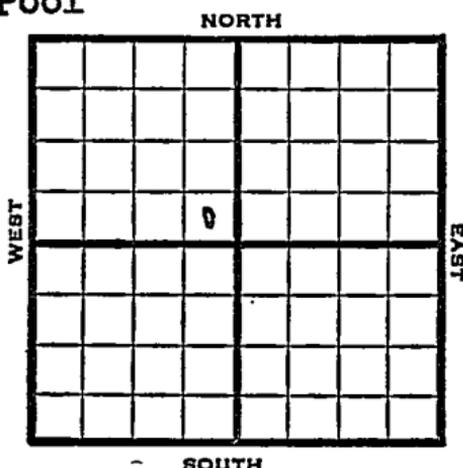

1953

Elev. 2154' REPORT

4/29

Spud 4-26-53  
8" @ 201'  
WOC

5/7

Heeb 3355' Lans 3403  
DST 3424-80, 1 hr, 90' gas, 90' O &  
GCM 650#  
DST 3478-3505, 1 hr, 45' SOCM 300#  
Drlg. 3505'

5/20

Spud 4-26-53 Oil well TD 3672  
8" @ 201 Heeb 3355 Lans 3403  
DST 3424-80 open 1 hr rec 90' gas,  
90' O & GCM 650#  
DST 3478-3505 open 1 hr rec 45' SOCM  
300# Arb. 3665 TD 3668  
5" @ 3666 DD 3672 750 A  
S/10 BOPH 8 hr.  
Comp. 50 BOPD

**COMPLETED**



