

O.W.W.O.

FORM 51.25M 8-50 WESTERN

Ellis

KANSAS


Section 24 Township 12 Range 18W

Well No. #2 Byers (A)

Company TRANS-ERA
B & R Drilling

NORTH

WEST

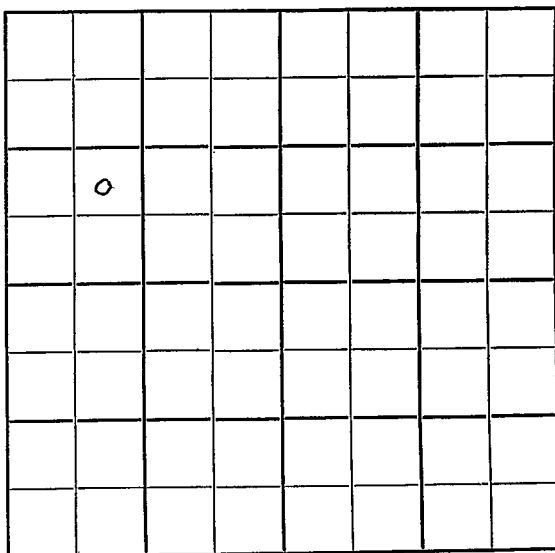

EAST

SOUTH

Sec. 24 Twp. 12 R. 18WWell No. #2 Byers (A) Farm~~TRANS-ERA~~
~~B & R Drlg.~~

Company

TRANS-ERA

Contractor

Ft. from N. Line

990


Ft. from S. Line

Ft. from E. Line

990

Ft. from W. Line

NE SW NW

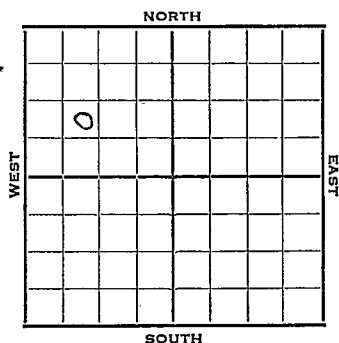

1952

Elev. 2152' REPORT

6/25

Location

7/2

10" @ 203 Anhy 1400 Drlg. 2790

7/9

Heeb. 3357 Lans. 3403 Simp 3651
Arb. 3655 RTD 3670 5" @ 3668

7/17

CO DD 3671 TD 1500A S/1 BOPH
2000 A

7/24

P/2 Boph for 12 hrs.

7/30

Spud 6-24-52

Oil well TD 3671' 10" @ 203

Anhy 1400' Heeb 3357' Lans. 3403'

Simp. 3651' Arb. 3655'

TD 3670' 5" @ 3668 DD 3671'

1500 A S/1 BOPH 2000 A P/2 BOPH

Comp. 35 BOPD

COMPLETED

O.W.W.O.

1954

6/2

Lans 3403', Simp. 3651', Arb.
3655'

5" @ 3668'

OTD 3670'

PB 3515'

18/3492-98, 6 goph 1 gw 24 boph 4 hrs.

OVER

1954
6/23

Oil Well - TD 3670'
Lans 3403', Simp 3651', Arb. 3655'
5" @ 3668'
OTD 3670'
PB 3515'
18/3492-98, 6 goph 1 gw 1000A
24 boph 4 hrs.
Comp. 50 bopd


COMPLETED

County **Ellis** State **Kansas**
 Sec. **24** (Blk. Twp.) **12** (Sur. Rge.) **18W** Map No.

Operator **B & R Drlg.**

Well No. **2** Farm **Byers (A)**

Elev. Location **NE SW NW**

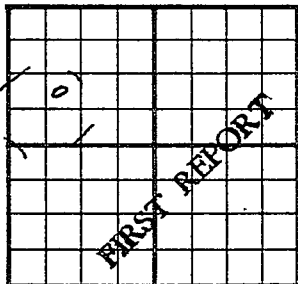

990 Ft. From **S** Line **NW**

990 Ft. From **W** Line Quarter

1st. Report **JUN ' 5 1952**

Completion

Remarks

Spudding Date

Drlg. Data

Location


J. G. McGEHEE

County Ellis State Kansas
 Sec. 24 (Blk.) 12 (Sur.) 18W Map No.

Operator B & R Drlg.

Well No. 2 Farm Byers "A"

Elev. 2152 Location NE SW NW

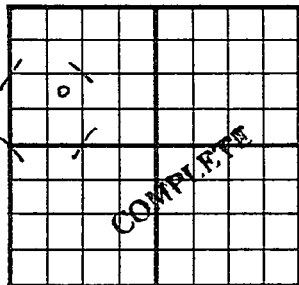

990 Ft. From S Line NW

990 Ft. From W Line Quarter

1st. Report

Completion JUL 30 1952

Remarks

Spudding Date 6-24-52

Drlg. Data Oil well TD 3671

10" @ 203 Anhy 1400 Heeb. 3357

Lans. 3403 Simp. 3651 Arb. 3655

TD 3670 5" @ 3668 DD 3671 1500 A

S/ 1 boph 2000 A P/ 2 boph

Comp. 35 bopd

J. G. McGEHEE

O.W.W.O.

County **Ellis** State **Kansas**

Sec. 24 (Blk. Twp.) 12 (Sur. Rge.) 18W Map No.

Operator **Trans-Era**

Well No. **2** Farm **Byers "A"**

Elev.	Location	NE	SE	NW
-------	----------	----	----	----

[illegible]

990 Ft. From S Line NW

990 Ft. From ~~IV~~ Line Quarter

1st. Report **JUN 2 1954**

Completion OWW

Remarks (OWTO)

Trans-Era - Contr.

Spudding Date _____

Drlg. Data

Lens. 3403 Simp. 3651 Arb. 3655


5" @ 3668 OTD 3670 PR 3515

18/ 3492-98 6 goph 1 gw 24 boph 4 hr.

J. G. McGEHEE

O.W.W.O.

County Ellis State Kansas
 Sec. 24 (Blk.) 12 (Sur.) 18W Map No.
 Operator Trans-Era
 Well No. 2 Farm Byers "A"
 Elev. Location NE SW NW

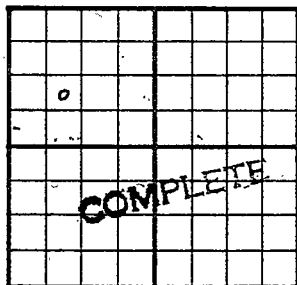990 Ft. From S Line. NW990 Ft. From W Line Quarter

1st. Report

Completion JUN 23 1954

Remarks

O.W.W.O.

Trans-Era - Contr.

Spudding Date

Drlg. Data Oil well TD 3670Lans. 3403 Simp. 3651 Arb. 36555" @ 3668 OTD 3670 PB 351518/ 3492-98 6 goph 1 gw 1000 A24 boph 4 hr. Comp. 50 bopd

J. G. McGEHEE