


Section 24 Township 12 Range 18 W

Well No. # 2 Byers "B"

Company Trans-Era

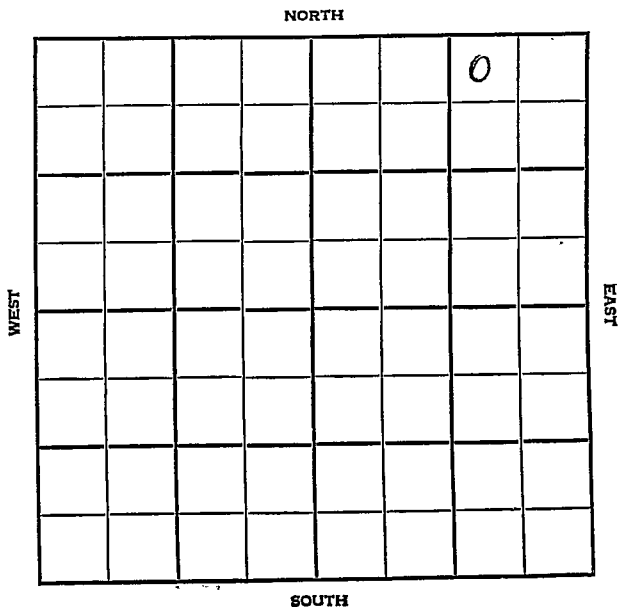

SEC.	TWP.	R.
24	12	18W

WELL NO. #2 Byers "B" FARM

COMPANY Trans-Era

CONTRACTOR Co. Tools.


Koblitz Pool

330 Ft. from N. Line

Ft. from S. Line

990 Ft. from E. Line

Ft. from W. Line

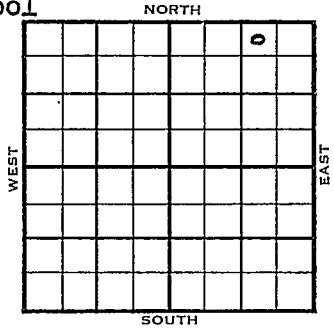

NW NE NE

1954	ELEVATION	REPORT
	2152' DF	

9/15 Location

9/29 Spud 9-15-54

D & A

TD 3721'

8-5/8" @ 188'

Anhy 1390', Heeb 3369', KC 3415'

DST 3483-3510' opn 1 hr, rec 5' ocm, 35' Muddy Wtr. 850#

DST 3552'-80' opn 56 min, rec 113' Mud O#

Arb 3710',

TD 3721'

D & A

ABANDONED

County Ellis State Kansas
 Sec. 24 (Blk. 12) (Sur. 18W) (Twp.) (Rge.) Map No.
 Operator Trans-Era
 Well No. 2 Farm Byers "B"
 Elev. 2152 DF Location NW NE NE

330 Ft. From N Line NE
990 Ft. From E Line Quarter
 Ist. Report Sep 15 1954
 Completion SEP 29 1954
 Remarks
Co. Tools
 Spudding Date 9-15-54

Drig. Data D & A TD 3721 Koblitz Pool
8 5/8" @ 188 Anhy 1390 Heeb. 3369
KC 3415 DST 3483-3510 open 1 hr. Rec.
5' ocm 35' muddy wtr. 850# DST 3552-80
open 56 min. Rec. 113' mud 0#
Arb. 3710 TD 3721

D & A

FABEN GILSTRAP