

Ellis County

KANSAS


FORM 51 5M 1-42 PETROL

KANSAS

Section 24 Township 12 Range 18W

Well No. 1 Edna Byres

Company Stanolind

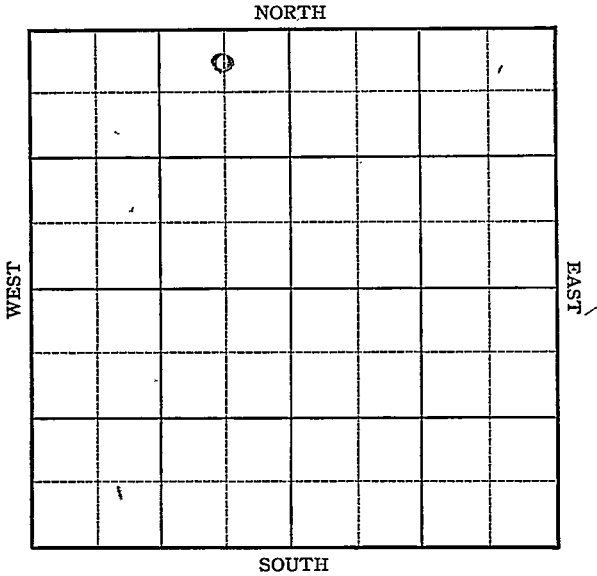

KANSAS

Ellis

Sec. 24 Twp. 12 R. 18W

Well No. #1 Edna Byres Farm
Stanolind Company


Walters

330' Ft. from N. Line

 Ft. from S. Line

660' Ft. from E. Line

 Ft. from W. Line

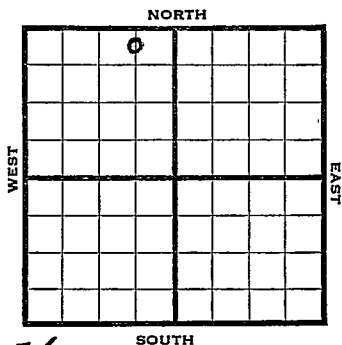

Elev. 2156

1944

REPORT

6/28

Rotary


7/19

Anhy 1400'
Topeka 3153
Lans 3430
Arb. 3763
TD 3814

ABANDONED

Pool Name Walters**KANSAS**Map No. 77 Sec. 24 Twp. 12 R. 18WWell No. 1 Edna ByresStanolind Company**FIRST REPORT**

Contractor

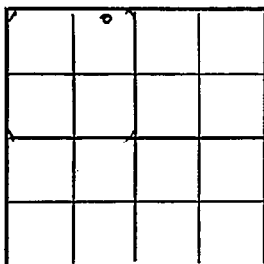C N L NE NW**SECTION PLAT**330 Ft. from N. Line Ft. from S. Line660 Ft. from E. Line Ft. from W. Line**Ellis County**Location Rig up

Drilling and Remarks:

Rotary**RECORD**Cased in., ft.Sand Gas Oil Total Depth **PRODUCTION**1st 24 hrs. Nat. 1st 24 hrs. after shot Gas Cu. Ft.Dry Hole Abandoned

Date

JUN 28 1941 19 S. J. LEWIS Scout

KANSAS

Pool Name WaltersMap No. 71 Sec. 24 Twp. 12 R. 18WWell No. 1 Edna ByresStanolind

Company

ABANDONED

Contractor

C N L NE NW

SECTION PLAT

330 Ft. from N. Line

Ft. from S. Line

660 Ft. from E. Line

Ft. from W. Line

Ellis County

Location

Rig up

Drilling and Remarks:

Perk 1400
Hofer 8153
Lane 3430
Or 8763

RECORD

Cased _____ in., _____ ft.

Sand _____

Gas _____

Oil _____

Total Depth 2874

PRODUCTION

1st 24 hrs. Nat. _____

1st 24 hrs. after shot _____

Gas _____ Cu. Ft.

Dry Hole _____

Abandoned _____

Date

JUL 1 9 1944 19S. J. LEWIS Scout