


Section 24 Township 12 Range 18W

Well No. #1 Madden

Company B & B Brlg.

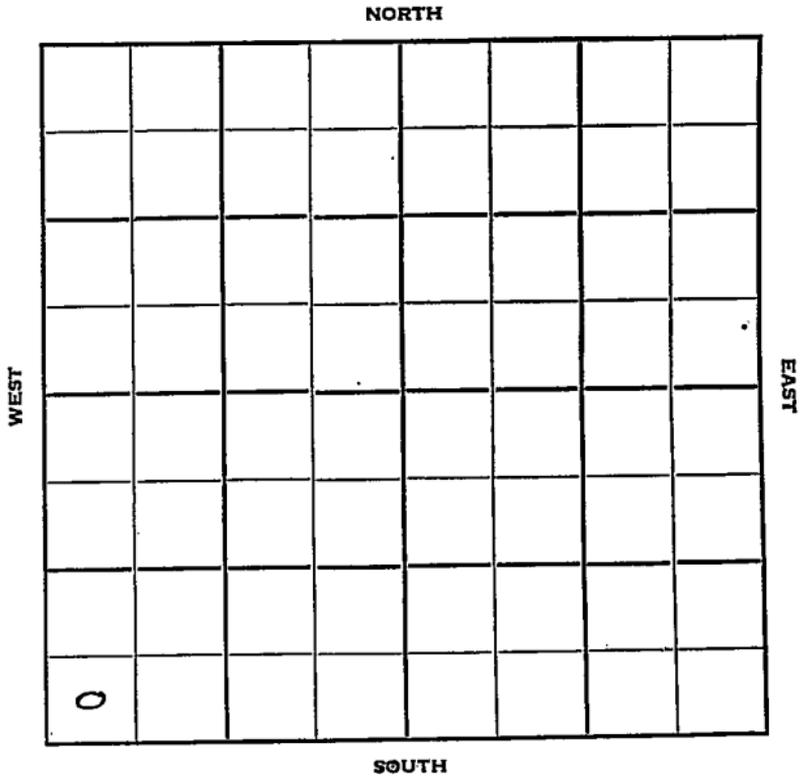

Sec. 24 Twp. 12 R. 18 W

Well No. # 1 Madden Farm

B & B Drlg. Company

B & B Contractor

Jensen


Ft. from N. Line

330 Ft. from S. Line

Ft. from E. Line

330 Ft. from W. Line

SW SW SW

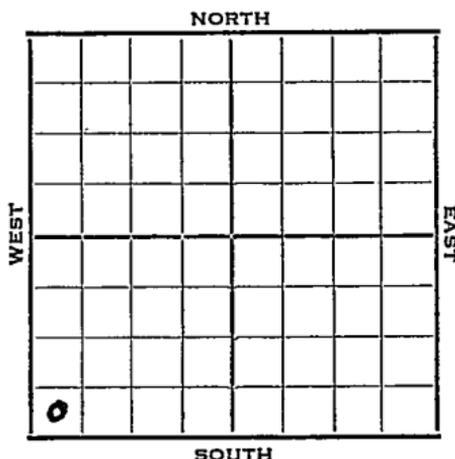

1952 Elev. 2125' REPORT

6/11 RU  
 6/18 8" @ 177 Anhy 1365'  
 Drlg. 3345'  
 6/25 Heeb 3320' Lans. 3367' Simp. 3621'  
 Arb. 3636'  
 RTD 3639' 5" @ 3638'  
 7/2 CO DD 3645 B/25 Galoph 500 A  
 7/9 POP  
 7/17 "  
 7/23 S/5 Boph  
 7/30 NR  
 8/6 Spud 6-11-52 Oil well TD 3645'  
 8" @ 177 Anhy 1365' Heeb 3320'  
 Lans. 3367'  
 DST 3385-3405 open 1/2 hr. rec 120' HOCM  
 180' oil 1160#  
 DST 3423-45 open 3/4 hr. rec 1740' oil  
 1110#  
 DST 3448-70 open 14 min. rec 340' HO &  
 GCM, 60' oil 1130#  
 DST 3490-3520 open 1/2 hr. rec 18' mud  
 890#  
 DST 3523-55 open 20 min. rec 300' oil  
 5' mud, 950#  
 DST 3500-3610 open 1 hr. rec 150' oil  
 & HOCM 700# Simp. 3621' Arb. 3636'  
 TD 3639' 5" @ 3638 DD 3645'  
 B/25 GOPH 500 A S/5 BOPH  
 Comp. 157 BOPD

COMPLETED



County Ellis State Kansas

Sec. 24 (Blk. 12 (Sur. 18W (Rge. Map No.)

Operator B & B Drlg.

Well No. 1 Farm Madden

Elev. 2125 Location SW SW SW

0					

330 Ft. From S Line SW

330 Ft. From W Line Quarter

Ist. Report

Completion AUG 6 1952

Remarks Jensen Pool

B & B Drlg. - Contr.

Spudding Date 6-11-52

COMPLETE

Drlg. Data Oil well TD 3645

8" @ 177 Anhy 1365 Heeb. 3320

Lans. 3367 DST 3385-3405 open 1/2 hr.

Rec. 120' hocm 180' oil 1160#

DST 3423-45 open 1/4 hr. Rec. 1740' oil

1110# DST 3448-70 open 14 min.

Rec. 340' ho & gcm 60' oil 1130#

DST 3490-3520 open 1/2 hr. Rec. 18' mud

890# DST 3523-55 open 20 min. Rec. 300'

oil 5' mud 950# DST 3500-3610

open 1 hr. Rec. 150' oil & hocm 700#

Simp. 3621 Arb. 3636 TD 3639

5" @ 3638 DD 3645 B/ 25 goph 500 A

S/ 5 boph Comp. 157 bopd

J. G. McGEHEE