


Ellis

Section 24 Township 12 Range 18 WWell No. # 3 Byers (A)Company B & R Drlg. Co.

NORTH

WEST

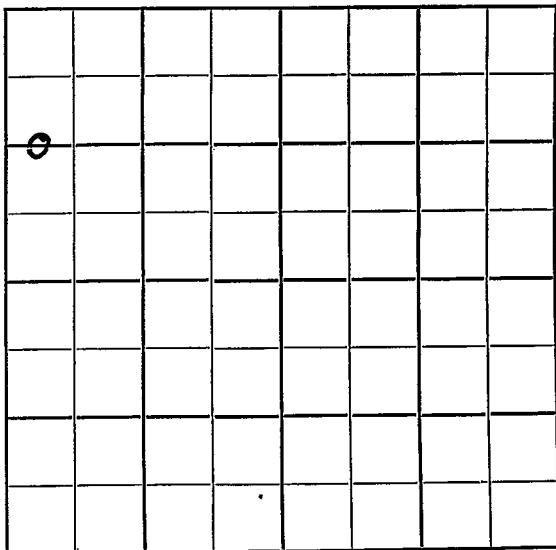

EAST

SOUTH

Ellis

KANSAS

Sec. 24 Twp. 12 R. 18W

Well No. #3 Byers (A) Farm

B. & R. Drlg. Co. Company

Contractor


1320' Ft. from N. Line

Ft. from S. Line

Ft. from E. Line

330' Ft. from W. Line

C W/2 W/2 NW

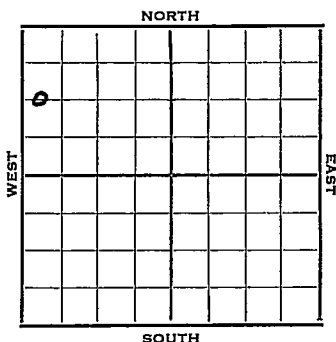

1952

Elev. 2148' REPORT

9/17 RU

9/24 8" @ 208 Anhy 1385'

Drlg. 2871'

10/1 Spud 9-16-52


D & A TD 3711' 8" @ 208

Anhy 1385' Heeb 3365' Lans. 3411

DST 3425-3511 open 1 hr. rec 150' mud

Cong. 3660' TD 3711' D & A

ABANDONED

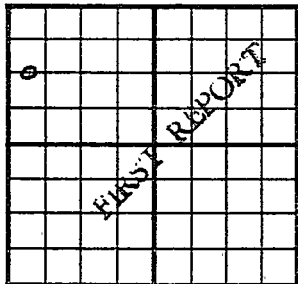County Ellis State KansasSec. 24 (Blk. Twp.) 12 (Sur. Rge.) 18W Map No.Operator B & R Drilg. Co.Well No. 3 Farm Byers (A)Elev. _____ Location C W/2 W/2 NW1320 Ft. From N Line NW330 Ft. From W Line Quarter1st. Report SEP 17 1952

Completion _____

Remarks _____


Spudding Date _____

Drilg. Data

RU

J. G. McGEHEE

County Ellis State Kansas
 Sec. 24 (Blk.) 12 (Sur.) 18W Map No.
 Operator B & R Drlg.
 Well No. 3 Farm Byers "A"
 Elev. 2148 Location C W $\frac{1}{2}$ W $\frac{1}{2}$ NW

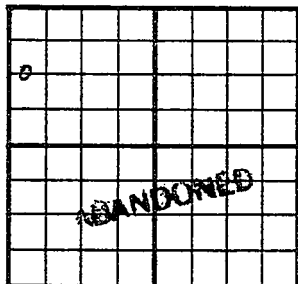

1320 Ft. From N Line NW
330 Ft. From W Line Quarter

1st. Report

Completion OCT 1 1952

Remarks

Spudding Date 9-16-52

Drlg. Data D & A TD 3711

8" @ 208 Anhy 1385 Heeb. 3365

Lans. 3411 DST 3425-3511 open 1 hr.

Rec. 150' mud Cong. 3660 TD 3711

D & A