


Section 24 Township 12 Range 18W

Well No. #1 Byers "B"

Company B & R Drlg.

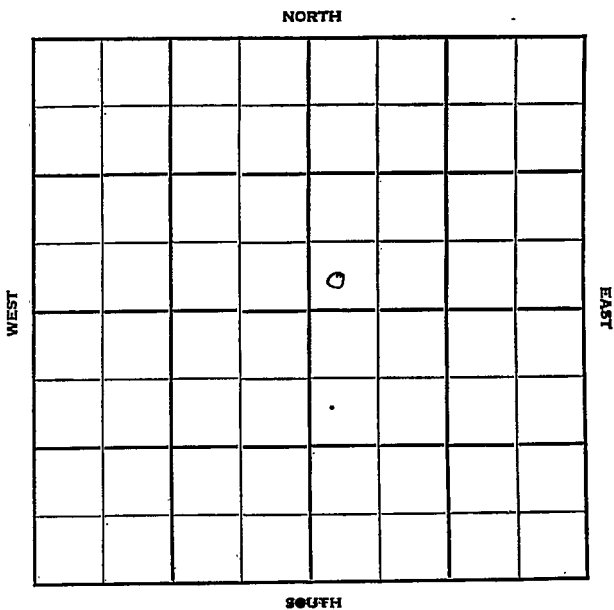

Sec. 24 Twp. 12 R. 18W

Well No. #1 Byers "B" Farm

B & R Drlg. Company

B & R Drlg. Contractor
Semi-Wildcat


_____ Ft. from N. Line

330 Ft. from S. Line

_____ Ft. from E. Line

330 Ft. from W. Line

SW SW NE

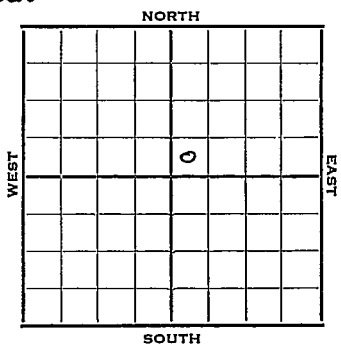

1952 Elev. 2164' REPORT

5/14 Spud 5-8-52
8" @ 194'
Anhy 1428
Drlg. 1700'

5/21 Heeb. 3384
DST 3186-3202 1 hr. 60' M 900# 20"
DST 3530 ? 1 hr. 90' M 60' wtry M
650# Drlg 3563

5/28 Spud 5-8-52
D & A TD 3735' 8" @ 194
Anhy 1428' Heeb 3384'
DST 3186-3202 open 1 hr. rec 60' mud
DST 3530-? open 1 hr. rec 90' mud
60' watery mud,
Lans. 3428' Cong. 3677' Re-Simp 3683
Arb. 3704'
TD 3735' D & A

ABANDONED

County **Ellis** State **Kansas**

Sec. **24** (Blk. Twp.) **12** (Sur. Rge.) **18W** Map No.

Operator **B & R Drlg.**

Well No. **1** Farm **Byers "B"**

Elev. Location **SW SW NE**

| | | | | | | | | | |
|-------------------|--|--|--|--|--|--|--|--|--|
| FIRST REPORT 0 | | | | | | | | | |
| | | | | | | | | | |
| | | | | | | | | | |
330 Ft. From **S** Line **NE**

330 Ft. From **W** Line Quarter

1st. Report **MAY 14 1952**

Completion

Remarks

B & R Drlg. - Contr.

Spudding Date **5-8-52**

Drlg. Data **Semi Wildcat**

8" @ 194 Anhy 1428 drlg. 1700

