


Section 24 Township 12 Range 18W

Well No. #1 Madden

Company Heathman & Co.

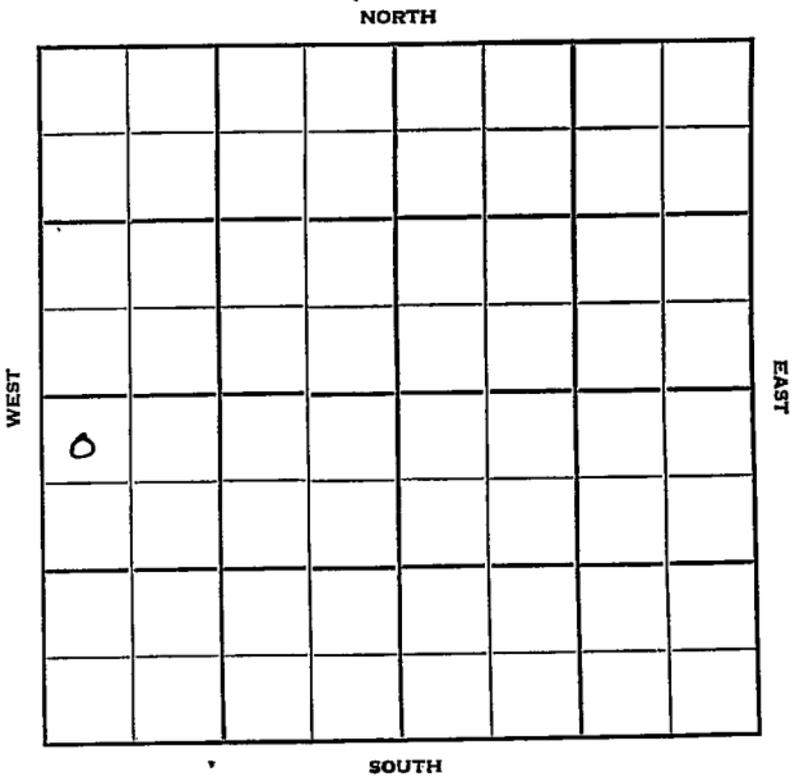

Ellis KANSAS

Sec. 24 Twp. 12 R. 18 W

Well No. # 1 Madden Farm

Heathman & Co. Company

Walters Contractor

Kablitz


330 Ft. from N. Line

\_\_\_\_\_ Ft. from S. Line

\_\_\_\_\_ Ft. from E. Line

330 Ft. from W. Line

NW NW SW

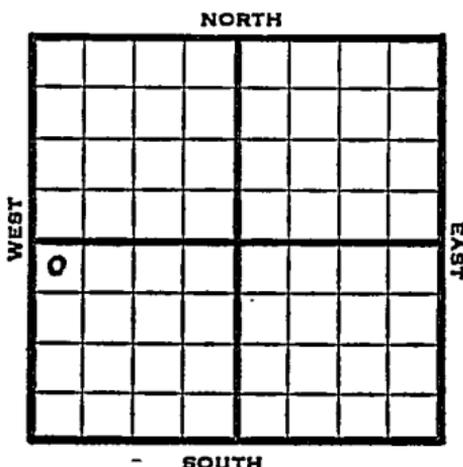

1952

Elev. 2133'

REPORT

1/9

Spud 1-7-52  
8" @ 160' WOC  
RUR

1/23

Spud 1-7-52  
D & A TD 3729' 8" @ 160  
Anhy 1370' Top. 3172' Heeb 3353  
Tor. 3372' Lans. 3398'  
DST 3462-97 open 45 min. rec 30' mud  
& water.  
B KC 3617' Cong. 3648'  
TD 3729'  
Arb. 3703' D & A

**ABANDONED**




County Ellis State Kansas

Sec. 24 (Blk. Twp.) 12 (Sur. Rge.) 18W Map No.

Operator Heathman & Co.

Well No. 1 Farm Madden

Elev. 2133 Location NW NW SW

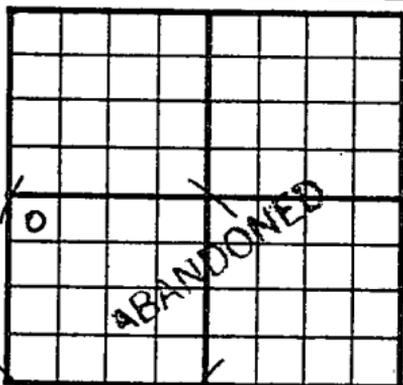

330 Ft. From N Line SW

330 Ft. From W Line Quarter

1st. Report

Completion JAN 23 1952

Remarks Koblitz Pool

Walters - Contr.

Spudding Date 1-7-52

Drig. Data D & A TD 3729

8" @ 160 Anhy 1370 Top. 3172

Heeb. 3353 Tor. 3372 Lans. 3398

DST 3462-97 open 45 min. Rec. 30' mud

& water B KC 3617 Cong. 3648

TD 3729 Arb. 3703

D & A