


Section 24 Township 12 Range 18 W

Well No. # 3 Madden

Company B & B Drlg.



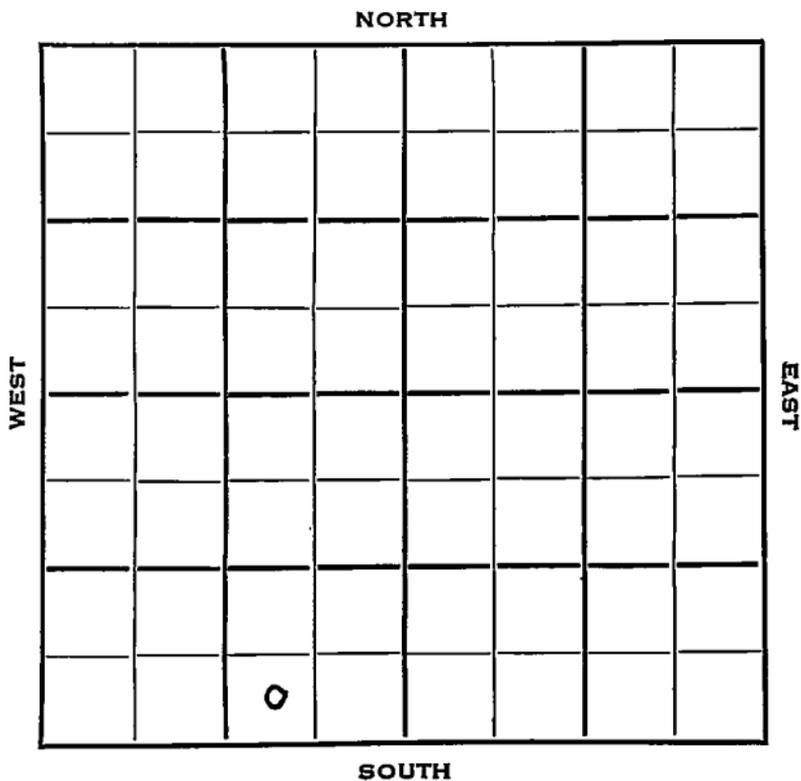

24

12

18W

Sec. _____ Twp. _____ R. _____

#3 Madden

Well No. _____ Farm _____

B & B Drlg.

Company

B & B Drlg.

Contractor

Jensen Pool

Ft. from N. Line

330


Ft. from S. Line

990

Ft. from E. Line

Ft. from W. Line

SW SE SW

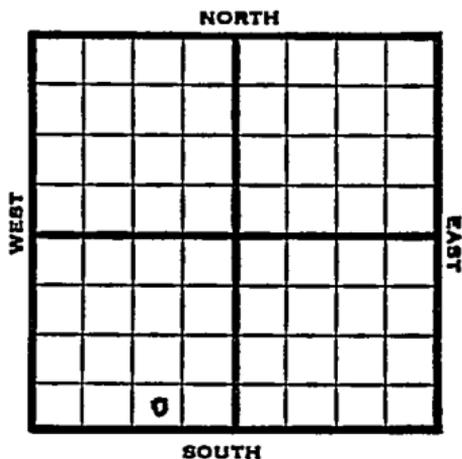

1953

Elev. 2143'

REPORT

4/15

Spud 4-11-53

8" @ 172

Anhy 1465

Drlg. 2440'

4/23

Top 3166

DST 3324-54, 1/2 hrs., 6' M 0#

Heeb 3372, Lans 3420

DST 3478-3515, 1/2 hrs., 40' SW, 650#

Cong 3668

DST 3625-75, 3/4 hrs., 6' M, 0 #

Drlg. 3675

4/29

Spud 4-11-53

D&A

TD 3700

8" @ 172

Anhy 1465, Top 3166

DST 3324-54, opn 1/2 hrs., rec. 6' mud 0#

Heeb 3372, Lans 3420

DST 3478-3515, opn 1/2 hrs., rec. 40' sw, 650#

Cong 3668

DST 3625-75, opn 3/4 hrs., rec. 6' mud 0#

TD 3700

D&A

ABANDONED

