



SIDE ONE

21

land

STATE CORPORATION COMMISSION OF KANSAS
OIL & GAS CONSERVATION DIVISION

WELL COMPLETION OR RECOMPLETION FORM
ACO-1 WELL HISTORY

DESCRIPTION OF WELL AND LEASE

Operator: License # 9896
Name Bonray Energy Corporation
Address 2644 NW 63rd St.
P.O. Box 20746
City/State/Zip Oklahoma City OK 73156

Purchaser

Operator Contact Person Lee Trojani
Phone (405)848-6891

Contractor: License # 5107
Name H-30, Inc.

Wellsite Geologist
Phone

Designate Type of Completion

- New Well
- Re-Entry
- Nonproductive
- Oil
- SWD
- Temp Abd
- Gas
- Inj
- Delayed Comp.
- Dry
- Other (Core, Water Supply etc.)

If OWWO: old well info as follows:

Operator
Well Name
Comp. Date Old Total Depth

WELL HISTORY

Drilling Method:

- Mud Rotary
- Air Rotary
- Cable

8-17-85 8-24-85 8-26-85
 Spud Date Date Reached TD Completion Date

4633'
 Total Depth PBDT

Amount of Surface Pipe Set and Cemented at 216 feet
 Multiple Stage Cementing Collar Used? Yes No
 If yes, show depth set.....feet
 If alternate 2 completion, cement circulated
 from.....feet depth to.....w/.....SX cmf

API NO. 15-195-21,765
 County Trego
 100' W of
 C.N/2 NW NE... Sec. 22.. Twp. 12S.. Rge. 25 East West

4950 Ft North from Southeast Corner of Section
 2080 Ft West from Southeast Corner of Section
 (Note: Locate well in section plat below)


Lease Name Walt Well # 22-1

Field Name

Producing Formation

Elevation: Ground 2512' KB 2517'

Section Plat

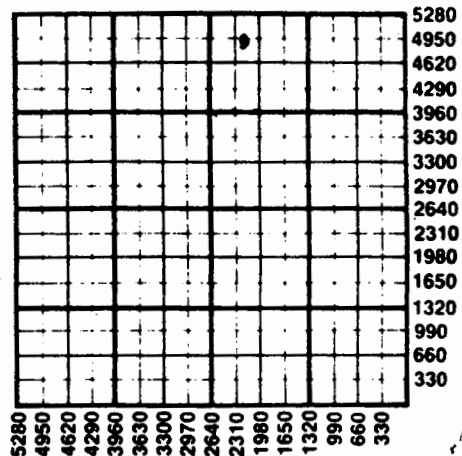

OCT 07 1985
State Geological Survey
WICHITA BRANCH

WATER SUPPLY INFORMATION

Disposition of Produced Water: Disposal
 Docket # Repressuring

Questions on this portion of the ACO-1 call:
 Water Resources Board (913) 296-3717

Source of Water:
 Division of Water Resources Permit #.....

Groundwater.....Ft North from Southeast Corner
 (Well)Ft West from Southeast Corner of
 Sec Twp Rge East West

Surface Water.....Ft North from Southeast Corner
 (Stream, pond etc).....Ft West from Southeast Corner
 Sec Twp Rge East West

Other (explain).....
 (purchased from city, R.W.D. #)

INSTRUCTIONS: This form shall be completed in duplicate and filed with the Kansas Corporation Commission, 200 Colorado Derby Building, Wichita, Kansas 67202, within 90 days after completion or recompletion of any well. Rule 82-3-130 and 82-3-107 apply.

Information on side two of this form will be held confidential for a period of 12 months if requested in writing and submitted with the form. See rule 82-3-107 for confidentiality in excess of 12 months.

One copy of all wireline logs and drillers time log shall be attached with this form. Submit CP-4 form with all proposed wells. Submit CP-111 form with all existing wells.

Operator Name Bonray Energy Corporation Lease Name Walt Well # 22-1

Sec. 22 Twp. 12S Rge. 25 East West County Trego

WELL LOG

INSTRUCTIONS: Show important tops and base of formations penetrated. Detail all cores. Report all drill stem tests giving interval tested, time tool open and closed, flowing and shut-in pressures, whether shut-in pressure reached static level, hydrostatic pressures, bottom hole temperature, fluid recovery, and flow rates if gas to surface during test. Attach extra sheet if more space is needed. Attach copy of log.

Drill Stem Tests Taken [] Yes [X] No
Samples Sent to Geological Survey [] Yes [] No
Cores Taken [] Yes [X] No

Formation Description [] Log [X] Sample

Table with 3 columns: Name, Top, Bottom. Rows include Shale & red bed, Shale, Sand & shale, Shale & lime, Shale, Shale & lime, Lime, Shale & lime, Lime, and Rotary total depth.

OCT 07 1985
State Geological Survey
WICHITA BRANCH

CASING RECORD, PERFORATION RECORD, TUBING RECORD, and Date of First Production/Producing Method section.