


DX 78-1

Section 25 Township 12 Range 18W

Well No. 2 Jensen

Company Elreco

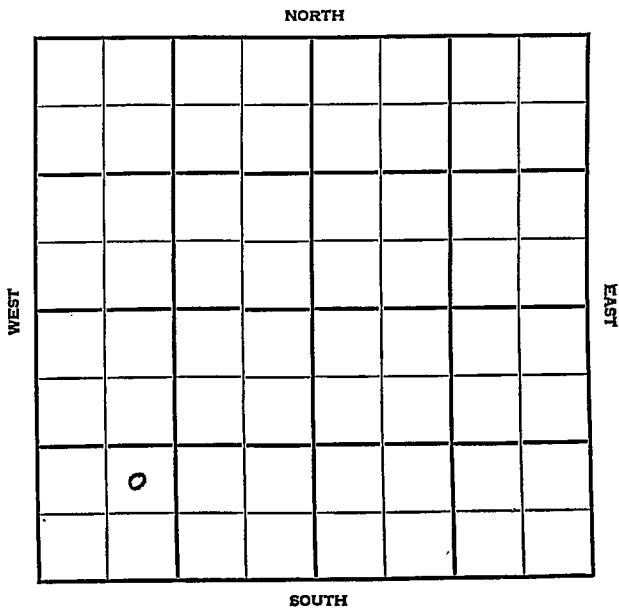

Ellis KANSAS

SEC. 25	TWP. 12	R. 18W ✓
WELL NO. 2 Jensen		
FARM Elreco		
CONTRACTOR Sterling Drlg.p-Contr.		

_____ Ft. from N. Line 990 _____ Ft. from S. Line _____ Ft. from E. Line 990 _____ Ft. from W. Line	WEST <table border="1" style="border-collapse: collapse; text-align: center;"> <tr><td colspan="8">NORTH</td></tr> <tr><td></td><td></td><td></td><td></td><td></td><td></td><td></td><td></td></tr> <tr><td></td><td></td><td></td><td></td><td></td><td></td><td></td><td></td></tr> <tr><td></td><td></td><td></td><td></td><td></td><td></td><td></td><td></td></tr> <tr><td></td><td></td><td></td><td></td><td></td><td></td><td></td><td></td></tr> <tr><td></td><td></td><td></td><td></td><td></td><td></td><td></td><td></td></tr> <tr><td></td><td></td><td></td><td></td><td></td><td></td><td></td><td></td></tr> <tr><td></td><td></td><td></td><td></td><td></td><td></td><td></td><td></td></tr> <tr><td></td><td></td><td></td><td></td><td></td><td></td><td></td><td></td></tr> <tr><td colspan="8">SOUTH</td></tr> </table> EAST	NORTH																																																																								SOUTH							
NORTH	
SOUTH	


NE SW SW

	ELEVATION	REPORT
1954	2119'	
6/15	Spdg. 6-12-54 8" @ 350 Anhy 1350 Drlg. 1415	
6/23	Spud 6-12-54 D&A TD 3672' 8" @ 350' Anhy 1350', Heeb 3347', Tor 3368', Eans 3391' DST 3412-37', opn 1 hr., rec. 25' mud, 450# DST 3462-92', opn 1 hr., rec. 35' SO&mud 750# DST 3546-79', opn 1 hr., rec. 6' mud, 0# Cong 3647' TD 3672' D&A	

ABANDONED

J. G. McGEHEE

County Ellis State Kansas
 Sec. 25 (Blk. 12) (Sur. 18W) Map No.
 Operator Elreco
 Well No. 2 Farm Jensen
 Elev. 2119 Location NE SW SW

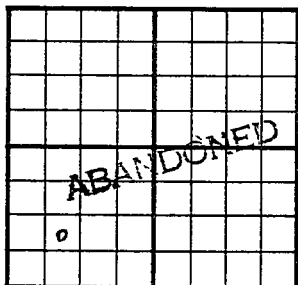

990 Ft. From S Line SW
990 Ft. From W Line Quarter
 Ist. Report
 Completion JUN 23 1954
 Remarks Sterling Drlg. - Contr.
 Spudding Date 6-12-54

Drlg. Data D & A TD 3672

8" @ 350 Anhy 1350 Heeb. 3347

Tor. 3368 Lans. 3391 DST 3412-37

open 1 hr. Rec. 25' mud 450#

DST 3462-92 open 1 hr. Rec. 35' so &

mud 750# DST 3546-79 open 1 hr.

Rec. 6' mud 0# Cong. 3647 TD 3672

D & A

J. G. McGEHEE