


Section 25 Township 12 Range 18W

Well No. #1 Schmeidler

Company B & R Drlg. Co.

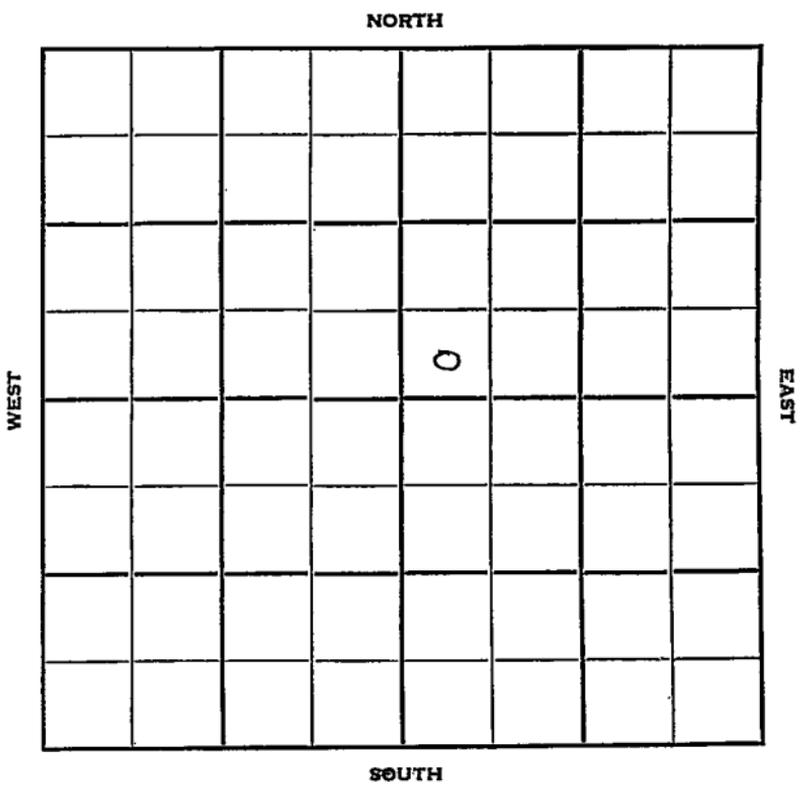

Sec. 25 Twp. 12 R. 18 W

Well No. # 1 Schmeidler Farm

B & R Drlg. Co. Company

B & R Contractor

Semi-Wildcat


 Ft. from N. Line

330 Ft. from S. Line

 Ft. from E. Line

330 Ft. from W. Line

SW SW NE

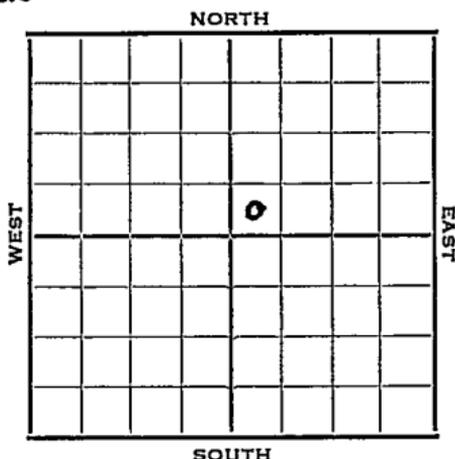

1952 Elev. 2139' REPORT

6/11 8" @ 195'

6/18 Anhy 1375'
Drlg. 2888'

6/25 Spud 6-11-52
D&A TD 3730' 8" @ 195'
Anhy 1375 Heeb. 3371
Lans. 3416
DST 3441-3516 open 1 hr. rec. 240' mud
Arb. 3695 TD 3730 D&A

ABANDONED

County Ellis State Kansas

Sec. 25 (Blk. Twp.) 12 (Sur. Rge.) 18W Map No.

Operator B & R Drilg. Co.

Well No. 1 Farm Schneidler

Elev. _____ Location SW SW NE

330 Ft. From S Line NE
330 Ft. From W Line Quarter

1st. Report JUN 11 1952

Completion _____

Remarks _____

B & R - Contr.

Spudding Date _____

Drilg. Data Semi Wildcat

8" @ 195

J. G. McGEHEE

