


DX 78-1 Ellis

KANSAS

Section 25 Township 12 Range 18W

Well No. #1 Staab

Company Kim Oil

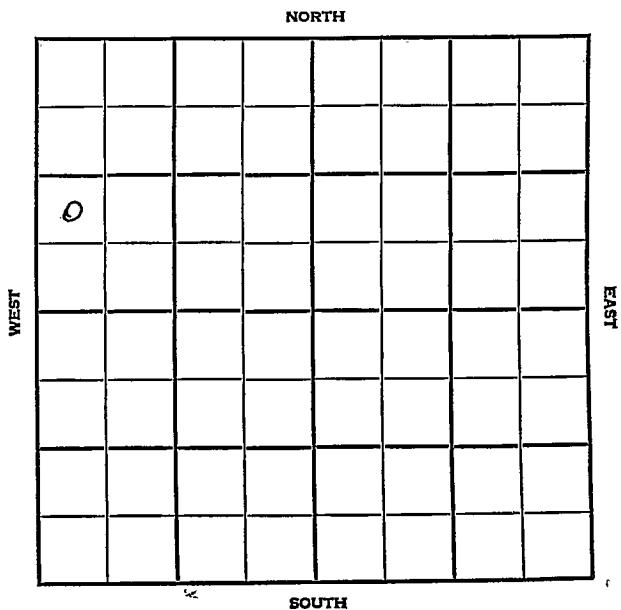

Ellis

KANSAS

SEC. 25	TWP. 12	R. 18W
------------	------------	-----------

WELL NO. #1 Staab FARM

COMPANY Kim Oil

CONTRACTOR Sidey

Jensen Pool


_____ Ft. from N. Line

990 _____ Ft. from S. Line

_____ Ft. from E. Line

330 _____ Ft. from W. Line

NW SW NW

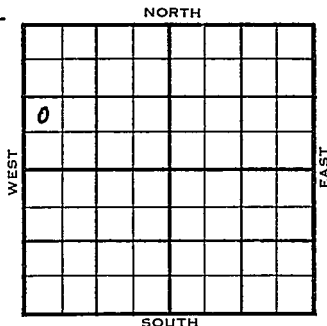

1954	ELEVATION 2099'	REPORT
------	--------------------	--------

11/11 Spud 11-5-54
 8" @ 192'
 Anhy 1337'
 Drlg. 2080'

1955
2/16

Spud 11-5-54
 D & A
 TD 3658'
 8" @ 192'
 Anhy 1337' Top 3067' Heeb 3315'
 Lans 3360', EroArb. 3563'
 TD 3581'
 5" @ 3576
 Cong 3615'
 TD 3658'
 5" @ 3658
 72/ 3490-3539 24/ 3451-56 40/
 3386-3400 85/ 3112-40 wtr.
 D & A

ABANDONED

County Ellis State Kansas

Sec. 25 (Blk. Twp.) 12 (Sur. Rge.) 18W Map No.

Operator Kim Oil

Well No. 1 Farm Staab

Elev. 2099 Location NW SWNW

990 Ft. From S Line NW

330 Ft. From W Line Quarter

1st. Report

FEB 16 1955

Completion

Remarks Jensen Pool

Sidey - Contr.

Spudding Date 11-5-54

ABANDONED

Drlg. Data D & A TD 3658

8" @ 192 Anhy 1337 Top. 3067

Heeb. 3315 Lans. 3360 EroArb. 3563

TD 3581 5" @ 3576 Cong. 3615 T^D 3658

5" @ 3658 72/ 3490-3539 24/ 3451-56

40/ 3386-3400 85/ 3112-40 wtr.

D & A

FABEN GILSTRAP