


Section 25 Township 12 Range 18-W

Well Number 1 Staab

Company Schaffer et al

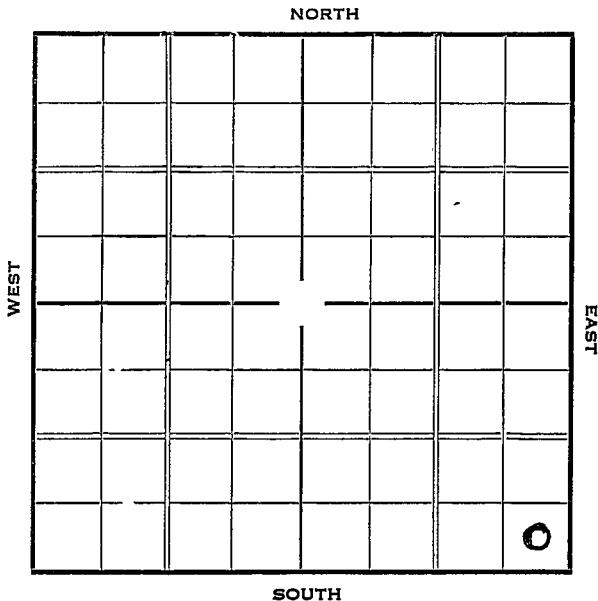

Map No. _____ Sec. 25 Twp. 12 R. 18W

Well No. 1 Start

Schaffer & Co Company

Contractor

Special

SECTION PLAT

_____ Ft. from N. Line

330 Ft. from S. Line

330 Ft. from E. Line

_____ Ft. from W. Line

			o

FIRST REPORT

Location ✓

Rig up _____

Drilling and Remarks:

RECORD

Cased _____ in., _____ ft.

Sand _____

Gas _____

Oil _____

Total Depth _____

PRODUCTION

1st 24 hrs. Nat. _____

1st 24 hrs. after shot _____

Gas _____ Cu. Ft.

Dry Hole _____

Abandoned _____

Date

APR 7 1937 19

S. J. LEWIS

Scout

Ellis KANSAS

Map No. _____ Sec. 25 Twp. 12 R. 18W

Well No. 1 - Staab

Schaffer et al Company
 _____ Contractor

ABANDONED

SECTION PLAT

 Ft. from N. Line
330 Ft. from S. Line
330 Ft. from E. Line
 Ft. from W. Line

			2

Location _____

Rig up _____

Drilling and Remarks:

DXA

RECORD

Cased _____ in., _____ ft.
 Sand 51/ 3828
 Gas _____
 Oil _____
 Total Depth 3841

PRODUCTION

1st 24 hrs. Nat. _____
 1st 24 hrs. after shot _____
 Gas _____ Cu. Ft.
 Dry Hole _____
 Abandoned _____

Date

MAY 26 1937

H. D. Hatfield

Scout