

**O.W.P.D.**

Ellis

KANSAS

Section 26 Township 12 Range 18W

Well No. #1 Jensen "B"

Company ~~B & R Drlg.~~  
Trans-Era

NORTH

WEST

EAST

|  |  |  |  |  |  |  |   |
|--|--|--|--|--|--|--|---|
|  |  |  |  |  |  |  | 0 |
|  |  |  |  |  |  |  |   |
|  |  |  |  |  |  |  |   |
SOUTH

W. P. B.

Ellis

KANSAS ✓

Sec. 26 Twp. 12 R. 18W

Well No. #1 Jensen "B" Farm

B & R Drlg. Company

Contractor

~~Koblitz~~ JENSEN POOL


330' Ft. from N. Line

Ft. from S. Line

330' Ft. from E. Line

Ft. from W. Line

NE NE NE

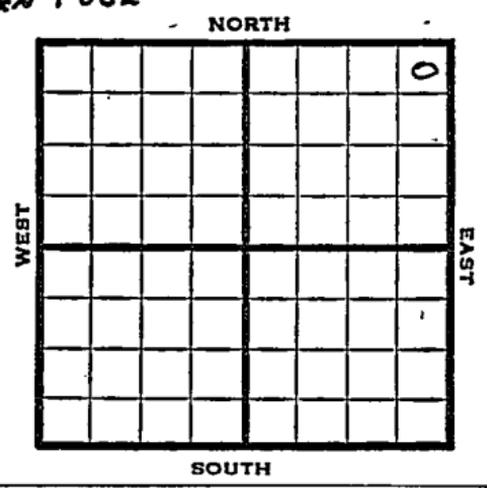

1952

Elev. 2097'

REPORT

1/23

Location

2/6

8" @ 174'  
Anhy 1345'  
Drlg. 1778'

2/13

DST 3265-90 1 hr 60' mud  
Heeb 3302 Lans. 3347  
DST 3376-3450 1 hr. 210' HOCM  
DrIg. 3541'

2/20

Arb. 3621' RTD 3623' 5" @ 3622'  
DP DD to 3625'TD  
Test 3 qts. Oil Per hr. 500 A

3/5

S/7 BOPH for 4 hrs. POP.  
Simp. Dol. 3604'  
Simp. shale 3607'

3/12

No report

3/19

NR

3/25

"

4/1

"

4/9

Spud 2-1-52 Oil Well  
TD 3625' 8" @ 174  
Anhy 1345'  
DST 3265-90 open 1 hr.  
rec. 60' mud  
Heeb. 3302 Lans. 3347  
DST 3376-3450 open 1 hr.  
rec. 210' hocm Arb. 3621  
TD 3623

OVER

1952

4/9

5" @ 3622! DD-3625  
3-qt. oph 500 A S/7 boph  
4 hr. Simp. dol. 3604  
Simp. sh 3607  
Comp. 79 bopd 3% wtr.

**COMPLETED**

**O. W. P. B.**

1953

4/29

KC 3347, Arb 3621  
OTD 3625  
5" @ 3622  
PB 3632, 12/3527-29, 12/3522-24,  
11/3512-14, 12/3504-06, 1000A  
S/5 boph 2% wtr., PB 3492  
24/3481-99, 1000A  
S/5 boph PB 3463  
24/3440-44, 24/3430-34, 24/3420-26  
1000A  
1stg.

5/6

Oil well TD 3625 KC 3347 Arb 3621  
OTD 3625 5" @ 3622 PB 3632  
12/3527-29 12/3522-24 11/3512-14  
12/3504-06 1000 A S/5 BOPH 2% wtr.  
PB 3492 24/3481-99 1000 A  
S/5 BOPH PB 3463 24/3440-44  
24/3430-34 24/3420-26 1000 A  
S/20 BOPH 4 hr. GO to 3536  
P/22 BOPH  
Comp. 464 BOPD

**COMPLETED**




County Ellis State Kansas

Sec. 26 (Blk. 12) (Sur. 18W) Map No.

Operator B & R Drlg.

Well No. 1 Farm Jensen

Elev. 2097 Location NE NE NE

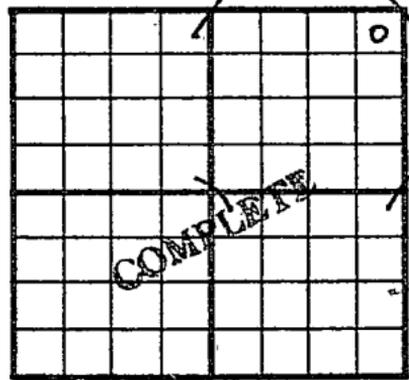

330 Ft. From N Line NE

330 Ft. From E Line Quarter

1st. Report

Completion APR 9 1952

Remarks Koblitz Pool

Spudding Date 2-1-52

Drlg. Data Oil well TD 3625

8" @ 174 Anhy 1345 DST 3265-90

open 1 hr. Rec. 60' mud Heeb. 3302

Lans. 3347 DST 3376-3450 open 1 hr.

Rec. 210' hocm Arb. 3621 TD 3623

5" @ 3622 DD 3625 3 qt. oph 500 A

S/ 7 boph 4 hr. Simp. dol. 3604

Simp. sh. 3607

Comp. 79 bopd 3% water

J. G. MCGEHEE



