


Section 26 Township 12 Range 18 W

Well No. # 2 Jensen "B"

Company Trans-Era

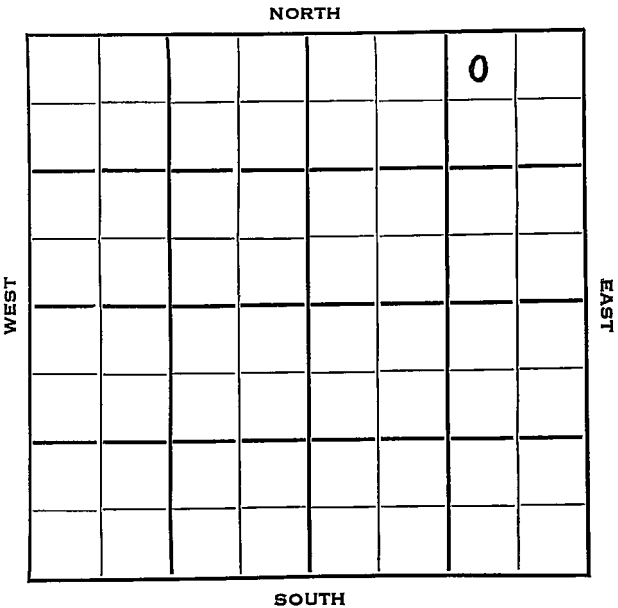

Ellis

SEC.	TWP.	R.
26	12	18W

WELL NO.

#2 Jensen "B"

FARM

COMPANY

Trans-Era

CONTRACTOR

Trans-Era

Koblitz Pool

330

Ft. from N. Line

Ft. from S. Line

990

Ft. from E. Line

Ft. from W. Line

NORTH

WEST

EAST

SOUTH

NW NE NE

ELEVATION

REPORT

1953

2089'

11/18

Spud 11-14-53

8" @ 177'

Anhy 1336'

Drlg 1506'

1954

1/20

Spud 11-14-53 Oil well TD 3640

8" @ 177' Anhy 1336' Heeb 3290

KC 3335'

DST 3364-3439 open 1 hr. 900' gas in pipe, 240' OG & GCM, 660' free oil, 690# Cong. 3604 TD 3640

5" @ 3640 CO to 3631' 43/3609-24

5 GW 12 hr. PB 3550 12/3502-06

22/3511-18 1000 A 53 BO 3 hr.

PB 3486 24/3471-76 1000 A

1 1/2 BO 1 hr. CO 3550 PB 3456

23/3428-33 11/3418-22 21/3407-12

2000 A S/33 BOPH 3 hr.

CO to 3550

Comp. 389 BOPD

COMPLETED

County Ellis State Kansas
 Sec. 26 (Blk.) 12 (Sur.) 18W Map No.
 Operator Trans-Era
 Well No. 2 Farm Jensen "B"
 Elev. Location NW NE NE

330 Ft. From N Line NE
990 Ft. From E Line Quarter
 1st. Report NOV 18 1953
 Completion
 Remarks
Trans-Era - Contr.
 Spudding Date 11-14-53

Drig. Data Koblitz Pool
8" @ 177 Anhy 1336 drig. 1506

County	Ellis		State	Kansas	
Sec.	26	(Blk. Twp.)	12	(Sur. Rge.)	18W Map No.
Operator	Trans-Era				
Well No.	2	Farm	Jensen "B"		
Elev.	2089	Location	NW NE NE		

0

COMPLETE

330 Ft. From	N	Line	NE
990 Ft. From	E	Line	Quarter

1st. Report

Completion JAN 20 1954

Remarks Koblitz Pool
Trans-Era - Contr.

Spudding Date 11-14-53

Drilg. Data:	Oil well	TD 3640
--------------	----------	---------

8" @ 177 Anhy 1336 Heeb. 3290

KC 3335 DST 3364-3439 open 1 hr.

900' gas in pipe 240' oc & gcm 660' free

oil 690# Cong. 3604 TD 3640 5" @ 3640

CO to 3631 43/ 3609-24 5 gw 12 hr.

PB 3550 12/ 3502-06 22/ 3511-18 1000 A

53 bo 3 hr. PB 3486 24/ 3471-76

1000 A $1\frac{1}{2}$ bo 1 hr. CO to 3550

PB 3456 23/ 3428-33 11/ 3418-22

21/ 3407-12 3000 A S/ 33 boph 3 hr.

CO to 3550 Comp. 389 bopd

J. G. McGEHEE